

CODED

Q 344 *can't locate*
2-63 ²⁴⁴⁰

WATER WELL DRILLERS LOG

Date: ~~Feb 28~~, 1963, Driller: Colville Water Supply County, Jackson
(Name)

(1) Owner of Land: H.E. Davis
(Name)
Escatawpa, Miss.
(Address)

(2) Location: 1/4, 1/4, Sec. 30 T. 7 R. 5,
5 miles N of Moss Point
(distance) (direction) (Nearest Town)

(3) Topography: FLAT
(Hilly) (Flat) (Level)

(4) Purpose of Well: Dom
(Domestic Irrigation
Municipal, Industrial, Other)

Description & Color of Materials Sand, Clay, Red Clay, Shell, etc.	Thick- ness Feet	Depth Feet
CLAY	20	22
sand	78	100
CLAY	133	233
sand	24	257

CODED


Information upon completion of well:

- (1) Diameter 1 1/4 inches.
- (2) Total Depth 257 feet.
- (3) Water Level 5'-8" feet below top of ground.
- (4) Cased to 247, Size 1 1/4"
- (5) Screen: Size 1008, Length 10"
- (6) Were any formations sealed against pollution?
yes, no.

If YES depth of formation _____

Why _____

Drillers Remarks: _____

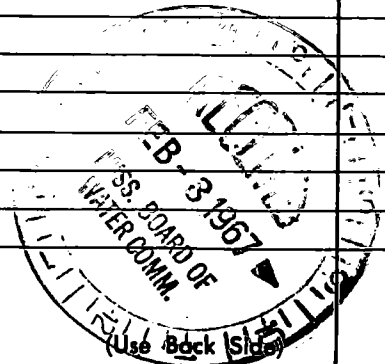

Well No. 2440

2000