

Q 345
2-20-63

WATER WELL DRILLERS LOG

1369

CODED

Date: 2-20, 1963, Driller: C.T. Sittiger Well Co. County Franklin
(Name)

(1) Owner of Land: Y. A. Harper
(Name)
Raymond
(Address)

(2) Location: 7 $\frac{1}{4}$, 8 $\frac{1}{4}$, Sec. 7 T 8 R 5,
_____ miles _____ of _____
(distance) (direction) (Nearest Town)

(3) Topography: X
(Hilly) (Flat) (Level)

(4) Purpose of Well: Domestic
(Domestic Irrigation
Municipal, Industrial, Other)

Description & Color of Materials Sand, Clay, Red Clay, Shell, etc.	Thick- ness Feet	Depth Feet
Sandy Clay	00	08
Soft Clay	08	21
Clay	21	29
Sand	29	22.1
Clay	22.1	21.5
Clay, w/ sand str	21.5	24.4
Sand	24.4	28.5
Clay	28.5	20.3
Sand	20.3	33.0
Clay	33.0	40.6
Clay w/ sand str	40.6	42.4
Sand	42.4	44.2
Clay	44.2	47.5
Sand, fine	47.5	48.4
Sand w/ clay str	48.4	50.4
Clay	50.4	58.8
Sand	58.8	61.4
Clay	61.4	62.5
Sand	62.5	65.5
Clay	65.5	65.9
Sand	65.9	66.9

Information upon completion of well:

(1) Diameter 4" inches.

(2) Total Depth 65.5 feet.

(3) Water Level 36' feet below top of ground.

(4) Cased to 65.5', Size 4"

(5) Screen: Size 4", Length 10'


(6) Were any formations sealed against pollution?
 yes, _____ no.

If YES depth of formation _____

Why Health Dept. Requirements

Drillers Remarks: _____

CODED

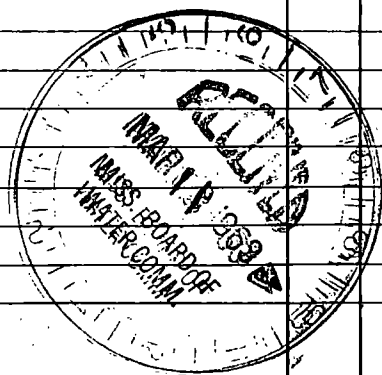

(Use Back Side)

Well No.

1000

1000