

JACKSON MISSISSIPPI BOARD OF WATER COMMISSIONERS

Q346 cont locate

3-28-63

WATER WELL DRILLERS LOG

CODED

2762

Date: March 28 1963, Driller: George Colville County Jackson
 (Name)

(1) Owner of Land: AT Knight
 (Name)
Gautier Miss.
 (Address)

(2) Location: NW 1/4, NE 1/4, Sec. 13 T 9 R 5
25 miles SW of Beauregard
 (distance) (direction) (Nearest Town)

(3) Topography: Flat
 (Hilly) (Flat) (Level)

(4) Purpose of Well: Domestic
 (Domestic Irrigation
 Municipal, Industrial, Other)

Description & Color of Materials Sand, Clay, Red Clay, Shell, etc.	Thick- ness Feet	Depth Feet
<u>Yellow Clay</u>		<u>50</u>
<u>Sand</u>	<u>38</u>	<u>88</u>
<u>Clay</u>	<u>92</u>	<u>180</u>
<u>Sand</u>	<u>28</u>	<u>208</u>
<u>Clay</u>	<u>10</u>	<u>218</u>
<u>Sand</u>	<u>24</u>	<u>242</u>

Information upon completion of well:

(1) Diameter 1 1/4 inches.

(2) Total Depth 242 feet.

(3) Water Level 14 feet below top of ground.


(4) Cased to _____, Size _____.

(5) Screen: Size 1 1/4, Length 10'

(6) Were any formations sealed against pollution?
 _____ yes, no.

CODED

If YES depth of formation _____
 Why _____
 Drillers Remarks: _____

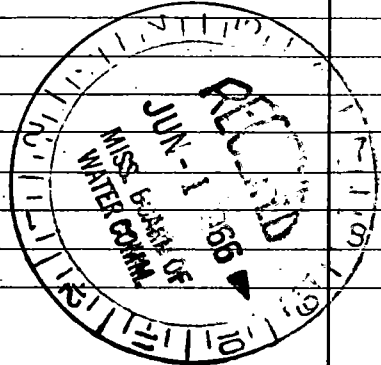

Well No.
000

(Use Back Side)

