

JACKSON  
 Q347  
 7-67

MISSISSIPPI  
 BOARD OF WATER COMMISSIONERS  
 416 North State Street  
 Jackson, Mississippi 39201  
 2265  
 WATER WELL DRILLERS LOG

**CODED**

7-29 1967 East Water Wellers Jackson  
 date well completed firm name county well located

LANDOWNER: Chas. W. [unclear]  
612 Yendele Rd  
Pascagoula Miss  
 (mailing address)

description of formations encountered	from to	
Red & Blue Clay	0	40
Sand fine - mixed	40	68


WELL LOCATION: City 5  
 sec 7 T 8 N R 10 E  
0 miles 0 in Pascagoula  
 (distance) (direction) (nearest town)

WELL PURPOSE: Drinking  
 (home, irrigation, municipal, industrial)

WELL COMPLETION DATA:

- diameter (inches) 2
- total depth (feet) 68
- static water level (feet) 12 below above top of ground.
- casing Galv., 63,  
 (material) (depth)  
2"  
 (size) if telescope see back.
- screen 5', 63  
 (length) (depth to top)  
2" Stainless Wrapped  
 (size) (material)
- pump 1/2, 10  
 (HP) (yield gpm)  
Elect.  
 (type power)
- electric log NO  
 (yes or no)  
 (organization running log)
- how well bottom plugged Back back  
Wash Valve


**CODED**

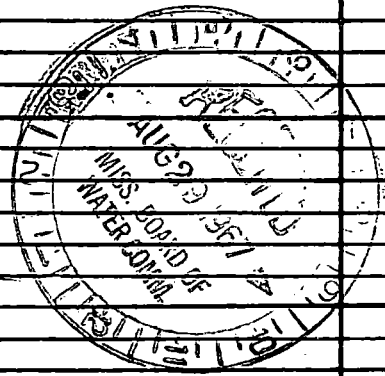

DRILLERS REMARKS:

If well telescopes please sketch and show depths.

GROUND LEVEL

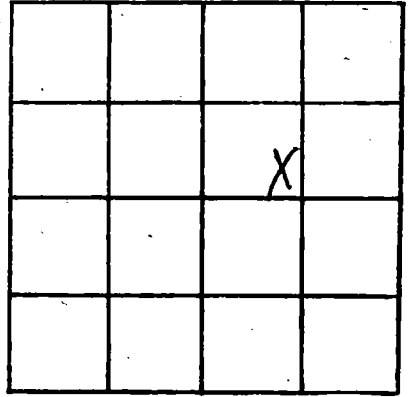

*City*

SECTION \_\_\_\_\_

Please indicate well location X.

ADDITIONAL INFORMATION

If more than one screen, show locations of each on sketch.