

JACKSON
 Q 349
 6-1-71

MISSISSIPPI
 BOARD OF WATER COMMISSIONERS
 416 North State Street
 Jackson, Mississippi 39201

CODED

WATER WELL DRILLERS LOG

June 1 19 71 Colville Water Supply Jackson
 date well completed firm name county well located

LANDOWNER: <u>Warren</u> <u>Orren</u>	description of formations encountered	from	to
<u>Orange Grove, Miss</u> (mailing address)			
WELL LOCATION: sec. <u>23</u> T <u>7</u> N R <u>6</u> E <u>6</u> miles <u>East</u> of <u>MP</u> (distance) (direction) (nearest town)	<u>Pile Clay</u>	<u>0</u>	<u>18</u>
WELL PURPOSE: <u>Home</u> (home, irrigation, municipal, industrial)	<u>Sugar sand</u>	<u>18</u>	<u>21</u>
WELL COMPLETION DATA: (1) diameter (inches) <u>2</u>	<u>" "</u>	<u>21</u>	<u>26</u>
(2) total depth (feet) <u>215</u>	<u>Sand</u>	<u>26</u>	<u>62</u>
(3) static water level (feet) <u>24</u> <u>below</u> above top of ground.	<u>Clay</u>	<u>62</u>	<u>63</u>
(4) casing <u>Galv.</u> <u>210</u> (material) (depth)	<u>Sand</u>	<u>68</u>	<u>131</u>
(size) If telescope see back.	<u>Sand with clay str.</u>	<u>131</u>	<u>152</u>
(5) screen <u>5'</u> <u>210</u> (length) (depth to top)	<u>Clay</u>	<u>132</u>	<u>162</u>
<u>2"</u> <u>Stainless</u> (size) (material)	<u>Sand</u>	<u>163</u>	<u>175</u>
(6) pump _____ (HP) _____ (yield gpm)			
(type power) _____			
(7) electric log <u>No</u> (yes or no)			
(organization running log) _____			
(8) how well bottom plugged <u>BP</u> <u>Value</u>			

CODED


JUL 19 1971

MISS. BD. OF
 WATER COMM.

DRILLERS REMARKS: Pump
Installed by owner

If well telescopes please sketch and show depths.

GROUND LEVEL

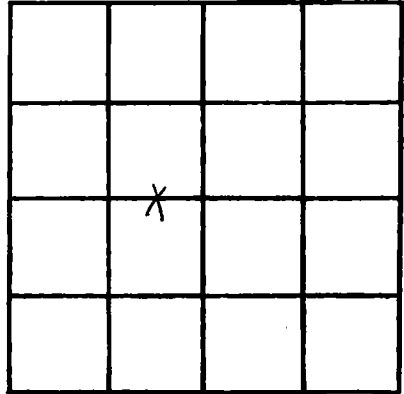

SECTION 23

Please indicate well location X.

ADDITIONAL INFORMATION

If more than one screen,
show locations of each on sketch.