

JACKSON

Q351

11-1-71

MISSISSIPPI BOARD OF WATER COMMISSIONERS  
416 North State Street  
Jackson, Mississippi 39201

**CODED**

WATER WELL DRILLERS LOG


Nov 1 1971 Cobble Water Supply Jackson  
date well completed firm name county well located

LANDOWNER: <u>Charles Webb</u>	description of formations encountered	from	to
<u>Bayou LaCrosse</u> (mailing address)	<u>Sand with clay streaks</u> <u>Clay</u> <u>Sand</u>	<u>0</u> <u>153</u> <u>192</u>	<u>153</u> <u>192</u> <u>268</u>
WELL LOCATION: sec <u>36</u> T <u>7</u> N R <u>5</u> E <u>6</u> miles <u>SE</u> of <u>M.P.</u> (distance) (direction) (nearest town)			
WELL PURPOSE: <u>Home</u> (home, irrigation, municipal, industrial)			
WELL COMPLETION DATA:			
(1) diameter (inches) <u>2</u>			
(2) total depth (feet) <u>268</u>			
(3) static water level (feet) <u>28</u> <sup>below</sup> above top of ground.			
(4) casing <u>galv</u> <u>263</u> (material) (depth)			
(size) If telescope see back.			
(5) screen <u>5</u> <u>263</u> (length) (depth to top)			
<u>2"</u> <u>Stainless</u> (size) (material)			
(6) pump <u>Aluminum</u> (HP) (yield gpm)			
(type power)			
(7) electric log <u>no</u> (yes or no)			
(organization running log)			
(8) how well bottom plugged <u>B.P. Valve</u>			
DRILLERS REMARKS: <u>Pump installed by owner</u>			

**CODED**

If well telescopes please sketch and show depths.

GROUND LEVEL

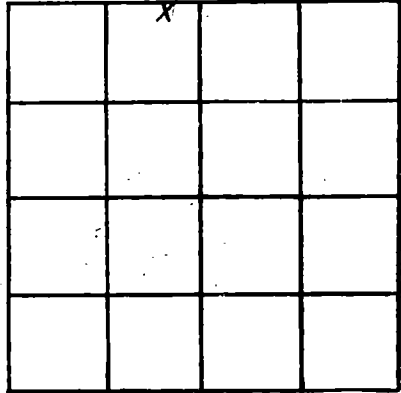

SECTION 36

Please indicate well location X.

ADDITIONAL INFORMATION

If more than one screen, show locations of each on sketch.