

JACKSON
Q 352
4-6-71

MISSISSIPPI
BOARD OF WATER COMMISSIONERS
416 North State Street
Jackson, Mississippi 39201
APR 21 1971
CODED
WATER WELL DRILLERS LOG

April 6 1971 Colville Water Supply Jackson
date well completed firm name county well located

LANDOWNER: L. N. Switzer
Orange Grove Miss.
(mailing address)

description of formations encountered	from	to
	<u>Clay sand</u>	<u>0</u>
	<u>69</u>	<u>193</u>

WELL LOCATION:
sec. 1 T 7 N R. 5 E
6 miles NE of MD
(distance) (direction) (nearest town)

WELL PURPOSE: home
(home, irrigation, municipal, industrial)


- WELL COMPLETION DATA:
- (1) diameter (inches) 2
 - (2) total depth (feet) 173
 - (3) static water level (feet) 5-6 ^{below} ~~above~~ top of ground.
 - (4) casing galv 168
(material) (depth)
(size) if telescope see back.
 - (5) screen 5 168
(length) (depth to top)
2 stainless
(size) (material)
 - (6) pump 1 10
(HP) (yield gpm)
elec
(type power)
 - (7) electric log NO
(yes or no)
(organization running log)
 - (8) how well bottom plugged BP Valve

CODED

DRILLERS REMARKS:

If well telescopes please sketch and show depths.

GROUND LEVEL

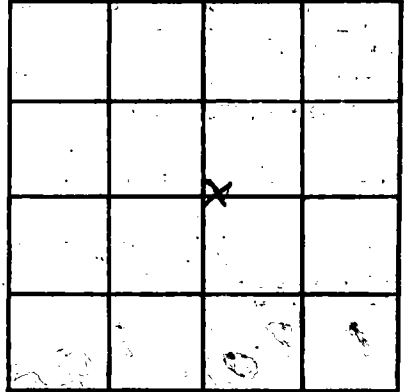

SECTION 1

Please indicate well location X.

ADDITIONAL INFORMATION

If more than one screen, show locations of each on sketch.