

JACKSON  
 Q 353  
 4-23-71

MISSISSIPPI  
 BOARD OF WATER COMMISSIONERS DEC 21 1971  
 416 North State Street  
 Jackson, Mississippi 39201

WATER WELL DRILLERS LOG

MISSISSIPPI  
**CODED**  
 county well located

April 23 1971 Carroll Water Supply firm name  
 date well completed

LANDOWNER: C. J. Hurd  
Orange Grove, Miss  
 (mailing address)

description of formations encountered	from	to
clay	0	42
sand	42	60
clay	60	80
sand	80	122
clay	122	138
sand	138	160

WELL LOCATION:  
 sec. 26 T 2 N R. 5 E  
5 miles East of MP  
 (distance) (direction) (nearest town)

WELL PURPOSE: house  
 (home, irrigation, municipal, industrial)

WELL COMPLETION DATA:

(1) diameter (inches) 7

(2) total depth (feet) 160

(3) static water level (feet) 8 below above top of ground.

(4) casing galv 155  
 (material) (depth)

       if telescope see back.  
 (size)

(5) screen 5 155  
 (length) (depth to top)

7 stainless  
 (size) (material)

(6) pump                
 (HP) (yield gpm)

        
 (type power)

(7) electric log no  
 (yes or no)

        
 (organization running log)


(8) how well bottom plugged blacked

**CODED**

DRILLERS REMARKS: gassy  
installed by owner

If well telescopes please sketch and show depths.

GROUND LEVEL

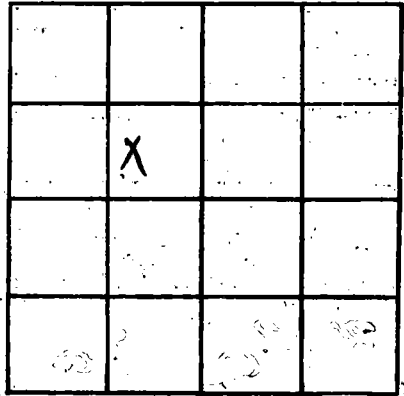

SECTION 26

Please indicate well location X.

ADDITIONAL INFORMATION

If more than one screen, show locations of each on sketch.