

JACKSON
Q 354
9-21-71

MISSISSIPPI
BOARD OF WATER COMMISSIONER
416 North State Street
Jackson, Mississippi 39201

CODED

WATER WELL DRILLERS LOG


Sept 21 1971 date well completed
Cottrell Water Supply firm name
Jackson county well located

LANDOWNER: <u>Alvin Hester</u>	description of formations encountered	from	to
<u>Orange Grove, Miss</u> (mailing address)	<u>clay</u> <u>sand</u> <u>clay</u> <u>sand</u>	<u>0</u> <u>16</u> <u>140</u> <u>195</u>	<u>16</u> <u>140</u> <u>195</u> <u>237</u>
WELL LOCATION: sec. <u>26</u> T <u>7</u> N R <u>E</u> E <u>5</u> miles <u>SE</u> of <u>Miss Point</u> (distance) (direction) (nearest town)			
WELL PURPOSE: <u>Home</u> (home, irrigation, municipal, industrial)			
WELL COMPLETION DATA: (1) diameter (Inches) <u>2</u> (2) total depth (feet) <u>237</u> (3) static water level (feet) <u>30</u> ^{below} above top of ground. (4) casing <u>galv</u> (material) (depth) ____ If telescope see back. (size) (5) screen <u>5</u> , <u>232</u> (length) (depth to top) <u>2</u> , <u>Hamline</u> (size) (material) (6) pump <u>1</u> , <u>20</u> (HP) (yield gpm) <u>elec</u> (type power) (7) electric log <u>no</u> (yes or no) ____ (organization running log) (8) how well bottom plugged <u>BP Valve</u>			
DRILLERS REMARKS:			

CODED

If well telescopes please sketch and show depths.

GROUND LEVEL

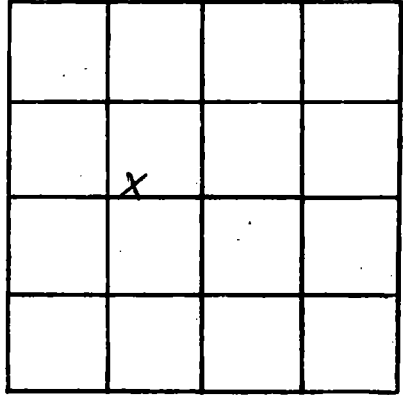

SECTION 26

Please indicate well location X.

ADDITIONAL INFORMATION

Lined area for additional information.

If more than one screen, show locations of each on sketch.