

JACKSON
 Q 355
 11-1-71

MISSISSIPPI
 BOARD OF WATER COMMISSIONERS
 416 North State Street
 Jackson, Mississippi 39201

DEC 21 1971
CODED

WATER WELL DRILLERS LOG


Nov 1 1971 Colville Water Supply Jackson
 date well completed firm name county well located

LANDOWNER: <u>Charles Webb</u>	description of formations encountered	from	to
<u>Boyou Cumbest</u> (mailing address)			
	<u>clay</u>	<u>153</u>	<u>195</u>
	<u>sand</u>	<u>195</u>	<u>268</u>
WELL LOCATION:			
sec. <u>36</u> T. <u>7</u> N R. <u>5</u> E			
<u>7</u> miles <u>SE</u> of <u>MP</u>			
(distance) (direction) (nearest town)			
WELL PURPOSE: <u>home</u> (home, irrigation, municipal, industrial)			
WELL COMPLETION DATA:			
(1) diameter (inches) <u>2</u>			
(2) total depth (feet) <u>268</u>			
(3) static water level (feet) <u>28</u> ^{below} _{above} top of ground.			
(4) casing <u>galv</u> (material), <u>263</u> (depth)			
_____ If telescope see back. (size)			
(5) screen <u>5</u> <u>263</u> (length) (depth to top)			
<u>2</u> <u>Stainless</u> (size) (material)			
(6) pump <u>1</u> <u>15</u> (HP) (yield gpm)			
<u>elc</u> (type power)			
(7) electric log <u>No</u> (yes or no)			
_____ (organization running log)			
(8) how well bottom plugged <u>BP Valve</u>			
DRILLERS REMARKS:			

CODED

If well telescopes please
sketch and show depths.

GROUND LEVEL

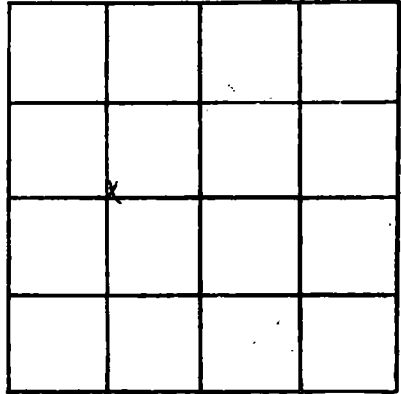

SECTION

36

Please indicate well location X.

ADDITIONAL INFORMATION

If more than one screen,
show locations of each on sketch.