

JACKSON
Q 359
4-24-71

MISSISSIPPI BOARD OF WATER COMMISSIONERS
 416 North State Street
 Jackson, Mississippi 39201

~~Planned for Dec 12/23/71~~

DEC 21 1971

WATER WELL DRILLERS LOG

MISS. BD. OF WATER COMM.


April 24 1971 Colville Water Supply firm name Jackson county well located
 date well completed

LANDOWNER: <u>Jesse Saulters</u>	description of formations encountered	from	to
<u>D Franklin Creek Min</u> (mailing address)	<u>yellow clay</u>	<u>0</u>	<u>30</u>
	<u>sand</u>	<u>30</u>	<u>77</u>
	<u>Clay</u>	<u>77</u>	<u>88</u>
	<u>sand</u>	<u>88</u>	<u>132</u>
WELL LOCATION: sec <u>31</u> T <u>7</u> N R <u>4</u> E <u>6</u> miles <u>NE</u> of <u>Missouri</u> (distance) (direction) (nearest town)			
WELL PURPOSE: <u>home</u> (home, irrigation, municipal, industrial)			
WELL COMPLETION DATA:			
(1) diameter (inches) <u>7</u>			
(2) total depth (feet) <u>132</u>			
(3) static water level (feet) <u>39</u> <u>below</u> above top of ground.			
(4) casing <u>Galv</u> , <u>127</u> (material) (depth)			
(size) if telescope see back.			
(5) screen <u>5'</u> , <u>127</u> (length) (depth to top)			
(size) <u>2</u> , <u>stainless</u> (material)			
(6) pump <u>1/2</u> , <u>8</u> (HP) (yield gpm)			
<u>elec</u> (type power)			
(7) electric log <u>no</u> (yes or no)			
(organization running log)			
(8) how well bottom plugged <u>BP Valve</u>			
DRILLERS REMARKS:			

CODED

If well telescopes please sketch and show depths.

GROUND LEVEL

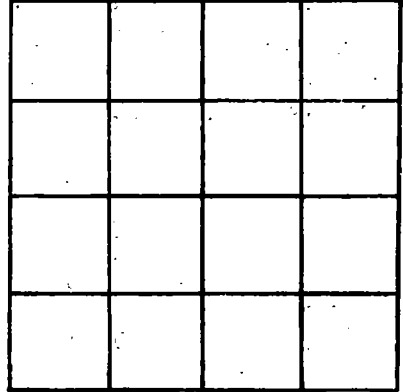

SECTION _____

Please indicate well location X.

ADDITIONAL INFORMATION

If more than one screen, show locations of each on sketch.