

JACKSON  
 Q 362  
 2-25-72

MISSISSIPPI  
 BOARD OF WATER COMMISSIONERS  
 416 North State Street  
 Jackson, Mississippi 39201

**CODED**

MAR 22 1972

WATER WELL DRILLERS LOG


2-25 1972 Coast Water Well Dr. Jackson  
 date well completed firm name county well located

LANDOWNER: <u>Horton Nelson</u>	description of formations encountered	from	to
<u>Bl-1</u>			
<u>Passapatanz, Miss.</u> (mailing address)	<u>top soil</u>	<u>0</u>	<u>15</u>
WELL LOCATION: sec. <u>13</u> T- <u>2</u> N R- <u>5</u> W <u>4</u> miles <u>East</u> of <u>Mass Point</u> (distance) (direction) (nearest town)	<u>fine to med.</u>	<u>15</u>	<u>84</u>
WELL PURPOSE: <u>Domestic use</u> (home, irrigation, municipal, industrial)	<u>blue clay</u>	<u>84</u>	<u>147</u>
WELL COMPLETION DATA: (1) diameter (inches) <u>2"</u>	<u>sand fine to med.</u>	<u>147</u>	<u>199</u>
(2) total depth (feet) <u>199</u>			
(3) static water level (feet) <u>30</u> below top of ground.			
(4) casing <u>galv.</u> (material) <u>189'</u> (depth)			
<u>2"</u> (size) If telescope see back.			
(5) screen <u>10'</u> (length) <u>189'</u> (depth to top)			
<u>2"</u> (size) <u>stainless tubing</u> (material)			
(6) pump <u>1</u> (HP) <u>10</u> (yield gpm)			
<u>elec.</u> (type power)			
(7) electric log <u>no</u> (yes or no)			
(organization running log)			
(8) how well bottom plugged <u>back wash valve</u>			
DRILLERS REMARKS:			

**CODED**

If well telescopes please sketch and show depths.

GROUND LEVEL

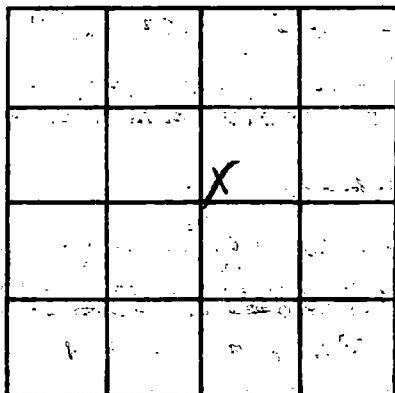

SECTION 13

Please indicate well location X.

ADDITIONAL INFORMATION

---

---

COOKED

If more than one screen, show locations of each on sketch.