

JACKSON
Q 363
4-12-72

MISSISSIPPI
BOARD OF WATER COMMISSIONERS
416 North State Street
Jackson, Mississippi 39201

WATER WELL DRILLERS LOG

CODED

April 17 1972 Palville Water Sup Jackson
date well completed firm name county well located

LANDOWNER: LARRY
You my
Helena MS
(mailing address)

WELL LOCATION:
sec. 7 T 7 N R 5 E
11 miles NE of MP
(distance) (direction) (nearest town)

WELL PURPOSE: home
(home, irrigation, municipal, industrial)


description of formations encountered	depth	
	from	to
clay	0	35
SAND	35	120
clay	120	180
Sand	180	195

- WELL COMPLETION DATA:
- (1) diameter (inches) 2
 - (2) total depth (feet) 195
 - (3) static water level (feet) 8 ^{below} above top of ground
 - (4) casing GALV (material), 190 (depth), (size) If telescope see back.
 - (5) screen 5' (length), 190 (depth to top), 2" (size), STAINLESS (material)
 - (6) pump 1/2 (HP), 6 (yield gpm), colc (type power)
 - (7) electric log no (yes or no)
(organization running log)
 - (8) how well bottom plugged B.P. valve

CODED


DRILLERS REMARKS:

If well telescopes please sketch and show depths.

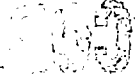

GROUND LEVEL

A large vertical rectangular area for sketching well telescopes, extending from the ground level line down to the bottom of the page.

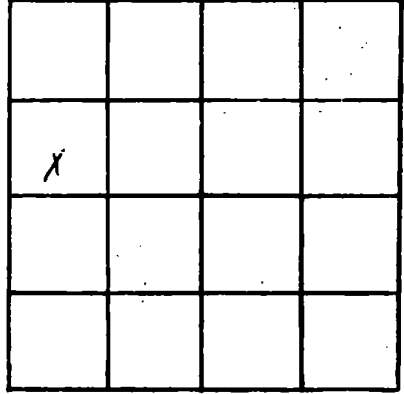

SECTION /

Please indicate well location X.

ADDITIONAL INFORMATION

A series of horizontal lines providing space for additional information, located below the grid and to the right of the main sketch area.

If more than one screen, show locations of each on sketch.