

JACKSON
Q364
5-3-72

MISSISSIPPI
BOARD OF WATER COMMISSIONERS
416 North State Street
Jackson, Mississippi 39201

CODED

WATER WELL DRILLERS LOG

May 3~~rd~~ 1972 Colville Water Sup JACKSON
date well completed firm name county well located

LANDOWNER: MARKIN
Caulley
Nelena Ms
(mailing address)

WELL LOCATION:
sec. 1 T. 7 N. R. 5 E.
11 miles NE of MP.
(distance) (direction) (nearest town)

description of formations encountered	from	to
Sandy clay and sand	0	111
Clay	111	132
SAND	132	205
Clay	205	296
SAND	296	306

WELL PURPOSE: home
(home, irrigation, municipal, industrial)

WELL COMPLETION DATA:

(1) diameter (inches) 2

(2) total depth (feet) 306

(3) static water level (feet) 30" below above top of ground.

(4) casing galv, 301,
(material) (depth)
(size) if telescope see back.

(5) screen 5', 301
(length) (depth to top)
2", STAINLESS
(size) (material)

(6) pump 1/2, 8
(HP) (yield gpm)
elec
(type power)

(7) electric log no
(yes or no)

(organization running log)

(8) how well bottom plugged BP/line

CODED


MAY 24 1972

MISSISSIPPI
WATER COMMISSION

DRILLERS REMARKS:

**If well telescopes please
sketch and show depths.**

GROUND LEVEL

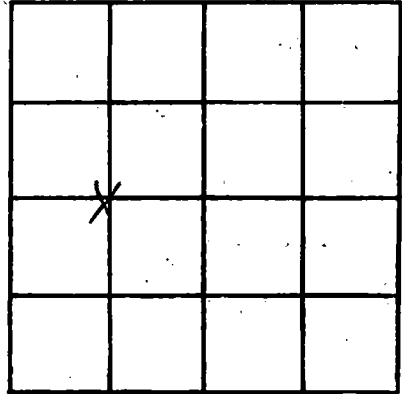

SECTION 2

Please indicate well location X.

ADDITIONAL INFORMATION

**If more than one screen,
show locations of each on sketch.**