

JACKSON

Q 367

7-6-72

MISSISSIPPI BOARD OF WATER COMMISSIONERS
416 North State Street
Jackson, Mississippi 39201

CODED

WATER WELL DRILLERS LOG

July 6 1972 Colville MS
date well completed firm name

Jackson
county well located

LANDOWNER: W. A. Cuffla
Mc ~~Smith~~
Bayona Crumfield
(mailing address)

WELL LOCATION:
sec 27 T 71 N R 5 E W
6 miles E of Moss Point
(distance) (direction) (nearest town)

WELL PURPOSE: home
(home, irrigation, municipal, industrial)

- WELL COMPLETION DATA:
- (1) diameter (inches) 2"
 - (2) total depth (feet) 260
 - (3) static water level (feet) 30 ^{below} above top of ground.
 - (4) casing galv. 255 (material) (depth)
If telescope see back.
(size)
 - (5) screen 54 255 (length) (depth to top)
2" stain (size) (material)
 - (6) pump 1 15 (HP) (yield gpm)
elec (type power)
 - (7) electric log no (yes or no)
(organization running log)
 - (8) how well bottom plugged 2" Hauler

description of formations encountered	from	to
soft Red clay	0	98
same	26	82
clay	82	110
sand	110	152
clay	152	190
remd	190	260
	197	257

CODED


SEP 28 1972

MISS. Bd. of WATER COMMISSIONERS

DRILLERS REMARKS:

If well telescopes please sketch and show depths.

GROUND LEVEL

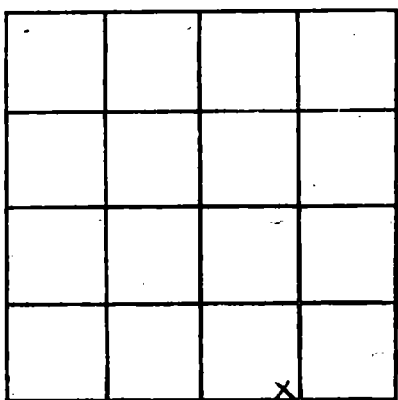

SECTION 21

Please indicate well location X.

ADDITIONAL INFORMATION

Multiple horizontal lines for entering additional information.

If more than one screen, show locations of each on sketch.