

JACKSON
 Q 368
 5-8-72

MISSISSIPPI
 BOARD OF WATER COMMISSIONERS
 416 North State Street
 Jackson, Mississippi 39201

CODED

WATER WELL DRILLERS LOG

May 9 1972 Colville W.S. Jackson
 date well completed firm name county well located

LANDOWNER: Mark Delmas
 Helena, Ms.
 (mailing address)

description of formations encountered	from	to
Clay	0	5
Sand	5	80
Clay	80	189
Sand	189	237
Sand	237	274

WELL LOCATION:
 sec. 5 T. 7 N. R. 5 E.
 (distance) miles (direction) of (nearest town)

WELL PURPOSE: Home
 (home, irrigation, municipal, industrial)

- WELL COMPLETION DATA:
- (1) diameter (inches) 2
 - (2) total depth (feet) ~~267~~ 269
 - (3) static water level (feet) 10 below top of ground
 - (4) casing gals (material) (depth) (size) if telescope see back. 269
 - (5) screen 5' (length) (depth to top) 2" STAIN (size) (material)
 - (6) pump 1/2 (HP) 6 (yield gpm) eled (type power)
 - (7) electric log no (yes or no) (organization running log)
 - (8) how well bottom plugged B.P. Vahel

CODED


SEP 28 1972

MISS. BO
 WATER CO.

DRILLERS REMARKS:

If well telescopes please sketch and show depths.

GROUND LEVEL

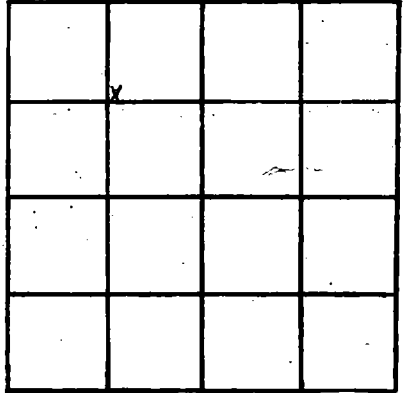

SECTION 5

Please indicate well location X.

ADDITIONAL INFORMATION

Lined area for additional information.

If more than one screen, show locations of each on sketch.