

JACKSON
Q369
6-28-72

MISSISSIPPI BOARD OF WATER COMMISSIONERS
416 North State Street
Jackson, Mississippi 39201
WATER WELL DRILLERS LOG

CODED

June 28 1972 Adville MS firm name Jackson county well located
date well completed

LANDOWNER: James La Force
Orange Grove
Miss.
(mailing address)

description of formations encountered	from	to
clay	0	27
sand	27	215
clay	215	216
sand	216	252

WELL LOCATION:
sec. 26 T. 57^N R. 5 E W. 3
6 miles E of Miss Pine
(distance) (direction) (nearest town)

WELL PURPOSE: home
(home, irrigation, municipal, industrial)

- WELL COMPLETION DATA:
- (1) diameter (inches) 2"
 - (2) total depth (feet) 258
 - (3) static water level (feet) 26 1/2 below top of ground.
 - (4) casing galv, 253,
(material) (depth)
 if telescope see back.
(size)
 - (5) screen 5, 253
(length) (depth to top)
2", alumin
(size) (material)
 - (6) pump 3/4, 15
(HP) (yield gpm)
elec
(type power)
 - (7) electric log no
(yes or no)

(organization running log)
 - (8) how well bottom plugged BB. Hall

CODED

SEP 28 1972


DRILLERS REMARKS:

2000

If well telescopes please sketch and show depths.

GROUND LEVEL

2000

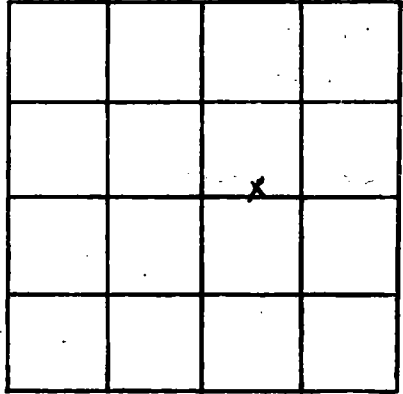

SECTION 26

Please indicate well location X.

ADDITIONAL INFORMATION

If more than one screen, show locations of each on sketch.