

JACKSON
 Q 372
 10-17-72

MISSISSIPPI
 BOARD OF WATER COMMISSIONERS
 416 North State Street
 Jackson, Mississippi 39201


WATER WELL DRILLERS LOG

Oct 17 1972 data well completed
 72 Colville Water Supply firm name
 Jackson county well located

LANDOWNER: <u>J. F. Kelley</u>	description of formations encountered	from	to
<u>Orange Grove</u> (mailing address)	<u>clay</u>	<u>0</u>	<u>18</u>
WELL LOCATION: sec. <u>23</u> T- <u>7</u> N R- <u>5</u> E <u>6</u> miles <u>EAST</u> of <u>M.P.</u> (distance) (direction) (nearest town)	<u>sand</u>	<u>18</u>	<u>216</u>
WELL PURPOSE: <u>home</u> (home, irrigation, municipal, industrial)	<u>clay</u>	<u>216</u>	<u>237</u>
WELL COMPLETION DATA: (1) diameter (inches) <u>2</u> (2) total depth (feet) <u>247</u> (3) static water level (feet) <u>27'-5"</u> ^{below} / _{above} top of ground. (4) casing <u>galv</u> , <u>242</u> , (material) (depth) _____ If telescope see back. (size) (5) screen <u>5</u> , <u>242</u> (length) (depth to top) <u>2"</u> , <u>stainless</u> (size) (material) (6) pump <u>1/2</u> , <u>10</u> (HP) (yield gpm) <u>elec</u> (type power) (7) electric log <u>no</u> (yes or no) _____ (organization running log) (8) how well bottom plugged <u>B.P. valve</u>	<u>clay</u>	<u>237</u>	<u>247</u>
DRILLERS REMARKS:			

If well telescopes please sketch and show depths.

GROUND LEVEL

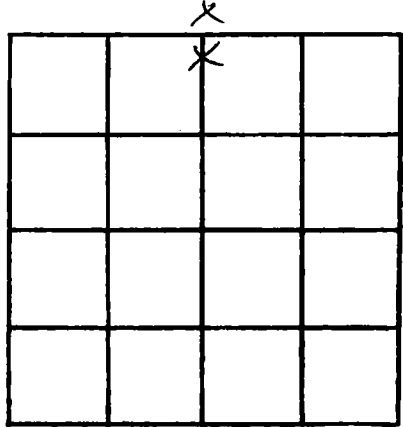

SECTION 23

Please indicate well location X.

ADDITIONAL INFORMATION

Lined area for additional information.

If more than one screen, show locations of each on sketch.