

JACKSON

Q 374

10-26-72

MISSISSIPPI
 BOARD OF WATER COMMISSIONERS
 416 North State Street
 Jackson, Mississippi 39201

WATER WELL DRILLERS LOG

Oct 26

1972

Cobille Water Supply

Jackson

date well completed


firm name

county well located

LANDOWNER: <u>Bob Webb</u>	description of formations encountered	from	to
(mailing address)	clay	0	15
WELL LOCATION:	sand	15	150
sec. <u>36</u> T. <u>2</u> N. R. <u>5</u> E	clay	150	205
6 miles <u>SE</u> of <u>MP</u>	silt	205	268
WELL PURPOSE: <u>home</u>			
(home, irrigation, municipal, industrial)			
WELL COMPLETION DATA:			
(1) diameter (inches) <u>2</u>			
(2) total depth (feet) <u>268</u>			
(3) static water level (feet) <u>40</u> ^{below} _{above} top of ground.			
(4) casing <u>galv</u> (material), <u>263</u> (depth)			
(5) screen <u>5</u> (length), <u>263</u> (depth to top)			
(6) pump <u>2</u> (HP), <u>10</u> (yield gpm)			
(7) electric log <u>no</u> (yes or no)			
(8) how well bottom plugged <u>B.P. Valve</u>			
DRILLERS REMARKS:			

If well telescopes please sketch and show depths.

GROUND LEVEL

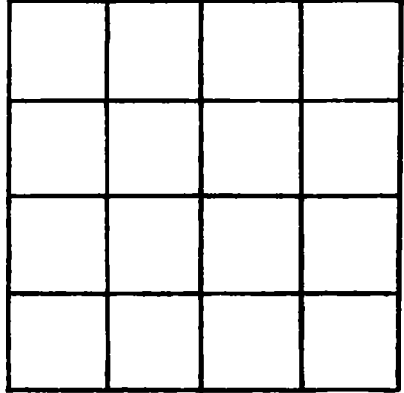

SECTION 36

Please indicate well location X.

ADDITIONAL INFORMATION

If more than one screen, show locations of each on sketch.