

JACKSON
 Q 375
 8-10-72

MISSISSIPPI
 BOARD OF WATER COMMISSIONERS
 416 North State Street
 Jackson, Mississippi 39201

WATER WELL DRILLERS LOG


Aug 10 1972 Robille W. S. Inc. Jackson
 date well completed firm name county well located

LANDOWNER: <u>A. L. Mahathy Jr.</u> <u>Kreok, Miss</u> (mailing address)	description of formations encountered	from	to
WELL LOCATION: sec. <u>20</u> T- <u>7</u> N R- <u>5</u> E <u>City of Moss Point</u> (distance) miles (direction) of (nearest town)	<u>sandy clay</u> <u>sand</u> <u>clay</u> <u>sand</u>	<u>0</u> <u>18</u> <u>190</u> <u>210</u>	<u>18</u> <u>190</u> <u>210</u> <u>257</u>
WELL PURPOSE: <u>house</u> (home, irrigation, municipal, industrial)			
WELL COMPLETION DATA: (1) diameter (inches) <u>2"</u> (2) total depth (feet) <u>257</u> (3) static water level (feet) <u>29</u> ^{below} above top of ground. (4) casing <u>galv</u> , <u>252</u> (material) (depth) (size) if telescope see back. (5) screen <u>5'</u> , <u>252</u> (length) (depth to top) <u>2"</u> , <u>stainless</u> (size) (material) (6) pump <u>1</u> , <u>8</u> (HP) (yield gpm) <u>elec</u> (type power) (7) electric log <u>no</u> (yes or no) (organization running log) (8) how well bottom plugged <u>B.P. Vohs</u>			
DRILLERS REMARKS:			

NOV 16 1972

If well telescopes please sketch and show depths.

GROUND LEVEL

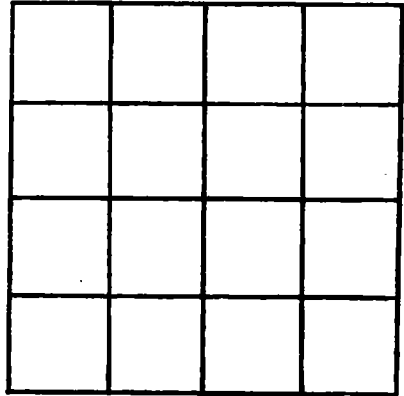

SECTION _____

Please indicate well location X.

ADDITIONAL INFORMATION

If more than one screen,
show locations of each on sketch.