

JACKSON
 Q 376
 10-24-72

MISSISSIPPI
 BOARD OF WATER COMMISSIONERS
 416 North State Street
 Jackson, Mississippi 39201

WATER WELL DRILLERS LOG

Oct 24 1972 data well completed
 White Water Supply firm name
 Jackson county well located

LANDOWNER: Pleasant
 M. Jindel
 Bayou Cumber Rd
 (mailing address)

description of formations encountered	from	to
clay	0	15
sand	15	48
clay	48	80
sand	80	153
clay	153	216

WELL LOCATION:
 sec. 36 T. 7 N. R. 5 E
 6 miles SE of MP
 (distance) (direction) (nearest town)

WELL PURPOSE: home
 (home, irrigation, municipal, industrial)

- WELL COMPLETION DATA:
- diameter (inches) 2
 - total depth (feet) 216
 - static water level (feet) 12 below top of ground
 - casing gal (material), 24 (depth)
 (size) If telescope see back.
 - screen 5 (length), 24 (depth to top)
 (size) (material)
 - pump 6 (HP), 0 (yield gpm)
 (type power)
 - electric log (yes or no)
 (organization running log)
 - how well bottom plugged


NOV 17 1972

DRILLERS REMARKS: _____

RD. OF
 WATER COMM.

If well telescopes please sketch and show depths.

GROUND LEVEL

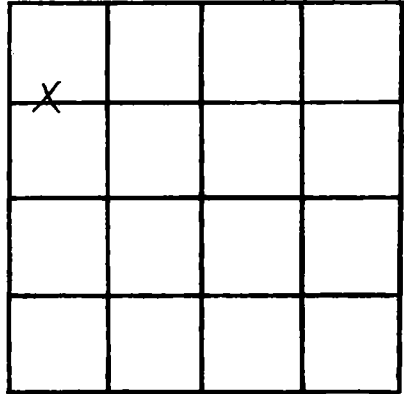

SECTION 36

Please indicate well location X.

ADDITIONAL INFORMATION

If more than one screen, show locations of each on sketch.