

JACKSON

Q378

10-2-72

MISSISSIPPI BOARD OF WATER COMMISSIONERS 416 North State Street Jackson, Mississippi 39201

WATER WELL DRILLERS LOG

Oct. 2

1972 coast Water Well Serv.

Jackson

date well completed

firm name

county well located

LANDOWNER: E. Stokes

description of formations encountered

from

to

Gen. Del. Kosok, Miss. (mailing address)

top soil 0 10

med. sand 10 69

WELL LOCATION:

blue clay 69 90

sec. 36 T. 7 S. R. 5 W. 5 miles E of Moss Point (distance) (direction) (nearest town)

med. sand & gravel 90 169

WELL PURPOSE: home (home, irrigation, municipal, industrial)

Blue clay 169 200

WELL COMPLETION DATA:

fine to coarse sand 200 270

- (1) diameter (inches) 2"
(2) total depth (feet) 270'
(3) static water level (feet) 30' below top of ground

- (4) casing (material) pvc (depth) 260'

2" (size) If telescope see back.

- (5) screen (length) 10' (depth to top) pvc 260'

2" (size) pvc (material)

- (6) pump (HP) 1 (yield gpm) 8

elec. (type power)

- (7) electric log NO (yes or no)

(organization running log)

- (8) how well bottom plugged backwash valve


CODE

DRILLERS REMARKS:

513

If well telescopes please sketch and show depths.

GROUND LEVEL

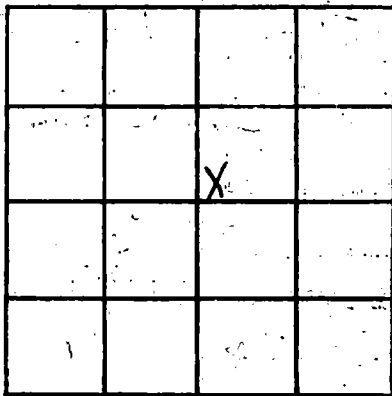

SECTION 36.

Please indicate well location X.

ADDITIONAL INFORMATION

If more than one screen, show locations of each on sketch.