

CODED

JACKSON
Q 381
1-25-73

MISSISSIPPI
BOARD OF WATER COMMISSIONERS
416 North State Street
Jackson, Mississippi 39201


WATER WELL DRILLERS LOG

1-25 1973 Coble Water Supply Jackson
date well completed firm name county well located

LANDOWNER: <u>C. V. Stork</u>	description of formations encountered	from	to
<u>Orange Grove, Ms</u> (mailing address)	<u>Sand</u>	<u>0</u>	<u>250</u>
WELL LOCATION: sec. <u>23</u> T. <u>7</u> N. R. <u>5</u> E	<u>clay</u>	<u>250</u>	<u>278</u>
<u>5</u> miles <u>EAST</u> of <u>M.P.</u> (distance) (direction) (nearest town)	<u>Sand</u>	<u>278</u>	<u>308</u>
WELL PURPOSE: <u>home</u> (home, irrigation, municipal, industrial)			
WELL COMPLETION DATA:			
(1) diameter (inches) <u>2</u>			
(2) total depth (feet) <u>308</u>			
(3) static water level (feet) <u>14-9</u> ^{below} _{above} top of ground.			
(4) casing <u>galv</u> <u>303</u> (material) (depth)			
(size) If telescope see back.			
(5) screen <u>5'</u> <u>303</u> (length) (depth to top)			
<u>2"</u> <u>stain</u> (size) (material)			
(6) pump _____ (HP) (yield gpm)			
(type power)			
(7) electric log <u>no</u> (yes or no)			
(organization running log)			
(8) how well bottom plugged <u>B.P. Valve</u>			
DRILLERS REMARKS: <u>pump installed by owner</u>	CODED APP A		

If well telescopes please sketch and show depths.

GROUND LEVEL

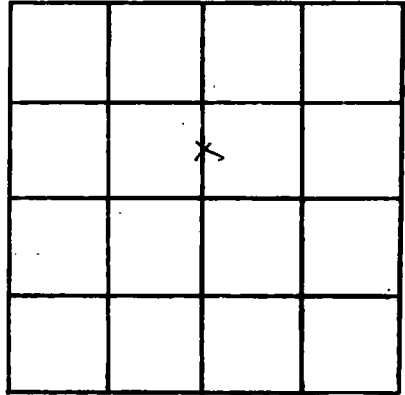

SECTION _____

Please indicate well location X.

ADDITIONAL INFORMATION

If more than one screen, show locations of each on sketch.