

JACKSON
Q 382
1-17-73

MISSISSIPPI
BOARD OF WATER COMMISSIONERS
416 North State Street
Jackson, Mississippi 39201

CODED

WATER WELL DRILLERS LOG

1-17 1973 Co Mill Water Supply Jackson
date well completed firm name county well located

LANDOWNER: M. R.

description of formations encountered

from to

Robinson
Helena Mrs.
(mailing address)

Clay	0	21
Sand	21	65
Clay	65	110
SAND	110	125
Clay	125	236
SAND	236	256

WELL LOCATION:

sec. 29 T. 7 N. R. 5 E. W
7 miles NE of MT.
(distance) (direction) (nearest town)

WELL PURPOSE: Home
(home, irrigation, municipal, industrial)

WELL COMPLETION DATA:

- (1) diameter (inches) 2
- (2) total depth (feet) 256
- (3) static water level (feet) 12 ^{below} _{above} top of ground.
- (4) casing galv 251
(material) (depth)
(size) if telescope see back.
- (5) screen 5' 251
(length) (depth to top)
2 STAINLESS
(size) (material)
- (6) pump 3/4 8
(HP) (yield gpm)
elec
(type power)
- (7) electric log NO
(yes or no)

(organization running log)

(8) how well bottom plugged B.P. Valve


DRILLERS REMARKS:

CODED

JAN 17 1973

If well telescopes please sketch and show depths.

GROUND LEVEL

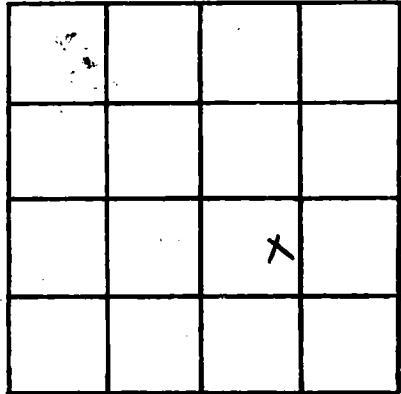

SECTION 29

Please indicate well location X.

ADDITIONAL INFORMATION

If more than one screen,
show locations of each on sketch.