

JACKSON

Q 384

3-22-73

MISSISSIPPI
BOARD OF WATER COMMISSIONERS
416 North State Street
Jackson, Mississippi 39201

COPIED

WATER WELL DRILLERS LOG

March 22 1973
date well completed

Colville Water Supply
firm name

Jackson
county well located

LANDOWNER: <u>Louis</u>	description of formations encountered	from	to
<u>Semam</u>			
<u>Orange Grove Ma.</u> (mailing address)	<u>SAND</u> <u>sandy clay</u> <u>SAND</u>	<u>0</u>	<u>124</u> <u>174</u> <u>195</u> <u>237</u>
WELL LOCATION:			
sec. <u>23</u> T <u>7</u> N R <u>5</u> E <u>4</u> miles <u>EAST</u> of <u>M.P.</u> (distance) (direction) (nearest town)			
WELL PURPOSE: <u>home</u> (home, irrigation, municipal, industrial)			
WELL COMPLETION DATA:			
(1) diameter (inches) <u>2"</u>			
(2) total depth (feet) <u>237</u>			
(3) static water level (feet) <u>25</u> <u>below</u> top of ground.			
(4) casing <u>Galv</u> , <u>232</u> , (material) (depth)			
(size) if telescope see back.			
(5) screen <u>5'</u> , <u>232</u> (length) (depth to top)			
<u>2"</u> , <u>Stainless</u> (size) (material)			
(6) pump <u>1</u> <u>10</u> (HP) (yield gpm)			
<u>she</u> (type power)			
(7) electric log <u>No</u> (yes or no)			
(organization running log)			
(8) how well bottom plugged <u>BP valve</u>			
DRILLERS REMARKS:			


COPIED

APR 1 1973

MISS. BD. OF
WATER COMMISSIONERS

If well telescopes please sketch and show depths.

GROUND LEVEL

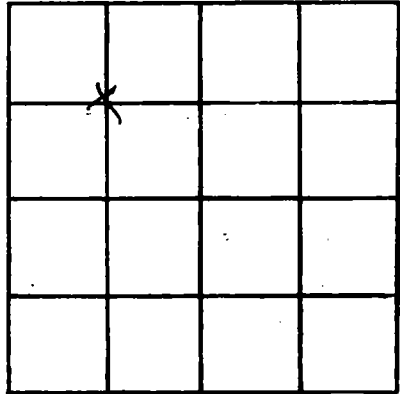

SECTION 23

Please indicate well location X.

ADDITIONAL INFORMATION

If more than one screen, show locations of each on sketch.