

JACKSON  
 Q 385  
 3-1-73


MISSISSIPPI  
 BOARD OF WATER COMMISSIONERS  
 416 North State Street  
 Jackson, Mississippi 39201

**CODED**

WATER WELL DRILLERS LOG


MARCH 1 1973 data well completed  
 Polville Water Supply firm name  
 JACKSON county well located

LANDOWNER: <u>Clarence</u>	description of formations encountered	from	to
<u>Mr Comack</u> <u>Orange Grove Ms.</u> (mailing address)	<u>sand</u> <u>sandy clay</u> <u>sand</u>	<u>0</u>	<u>174</u> <u>174</u> <u>195</u> <u>195</u> <u>215</u>
<b>WELL LOCATION:</b>			
sec. <u>23</u> T. <u>7</u> N R. <u>5</u> E <u>4</u> miles <u>EAST</u> of <u>MP</u> (distance) (direction) (nearest town)			
<b>WELL PURPOSE:</b> <u>home</u> (home, irrigation, municipal, industrial)			
<b>WELL COMPLETION DATA:</b>			
(1) diameter (inches) <u>2</u>			
(2) total depth (feet) <u>265</u>			
(3) static water level (feet) <u>25-1/2</u> <sup>below</sup> <u>above</u> top of ground.			
(4) casing <u>Galv</u> , <u>260</u> , (material) (depth)			
(size) if telescope see back.			
(5) screen <u>5'</u> , <u>260</u> (length) (depth to top)			
<u>2"</u> , <u>STAINLESS</u> (size) (material)			
(6) pump <u>1</u> , <u>10</u> (HP) (yield gpm)			
<u>ele</u> (type power)			
(7) electric log <u>NO</u> (yes or no)			
(organization running log)			
(8) how well bottom plugged <u>B.P. Value</u>			
<b>DRILLERS REMARKS:</b>			

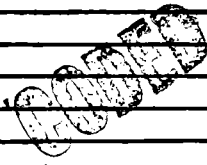

If well telescopes please sketch and show depths.

GROUND LEVEL

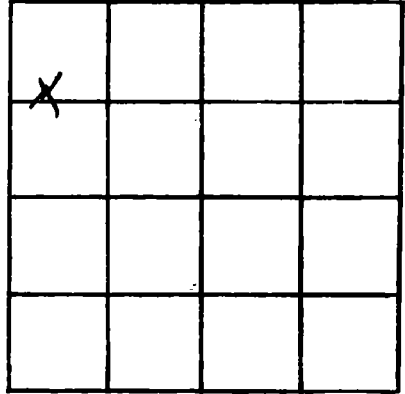

SECTION 23

Please indicate well location X.

ADDITIONAL INFORMATION

If more than one screen, show locations of each on sketch.