

JACKSON
Q 386
3-2-72

MISSISSIPPI
BOARD OF WATER COMMISSIONERS
416 North State Street
Jackson, Mississippi

CODED

WATER WELL DRILLERS LOG


March 2, 1972 Colville Water Supply Jackson
date well completed firm name county well located

LANDOWNER: <u>F. W. Fletcher</u>	description of formations encountered	from	to
<u>Orange Grove</u> (mailing address)	<u>Surface</u> <u>Sand</u> <u>Sandy clay</u> <u>SAND</u>	<u>0</u> <u>5</u> <u>153</u> <u>195</u> <u>195</u> <u>237</u>	<u>5</u> <u>153</u> <u>195</u> <u>237</u>
WELL LOCATION: sec <u>23</u> T <u>7</u> N R <u>5</u> E <u>4</u> miles <u>EAST</u> of <u>MP</u> (distance) (direction) (nearest town)			
WELL PURPOSE: <u>HOME</u> (home, irrigation, municipal, industrial)			
WELL COMPLETION DATA: (1) diameter (inches) <u>2"</u> (2) total depth (feet) <u>237</u> (3) static water level (feet) <u>25-6</u> ^{below} above top of ground. (4) casing <u>Galv</u> , <u>232</u> , (material) (depth) (size) if telescope see back. (5) screen <u>5'</u> , <u>232</u> (length) (depth to top) <u>2"</u> , <u>STAIN</u> (size) (material) (6) pump <u>1</u> , <u>10</u> (HP) (yield gpm) <u>elec</u> (type power) (7) electric log <u>NO</u> (yes or no) (organization running log) (8) how well bottom plugged <u>BP Valve</u>			
DRILLERS REMARKS:			

CODED

If well telescopes please sketch and show depths.

GROUND LEVEL

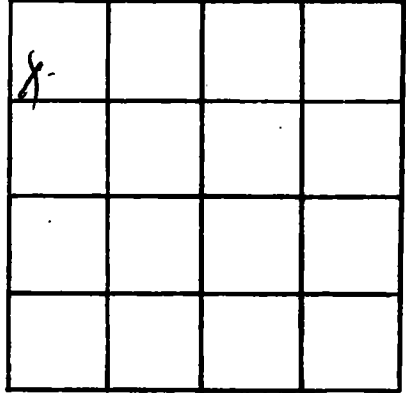

SECTION 23

Please indicate well location X.

ADDITIONAL INFORMATION

If more than one screen, show locations of each on sketch.