

JACKSON
Q 390
10-12-72
~~Oct 12~~

MISSISSIPPI
BOARD OF WATER COMMISSIONERS
416 North State Street
Jackson, Mississippi 39201

COBED

WATER WELL DRILLERS LOG


Oct 12 1972 Colville Water Supply JACKSON
date well completed firm name county well located

LANDOWNER: <u>A. E. Ramsay</u>	description of formations encountered	from	to
<u>Orange Grove Ms</u> (mailing address)	<u>Clay</u>	<u>0</u>	<u>55</u>
WELL LOCATION: sec. <u>6</u> T. <u>7</u> N. R. <u>5</u> E <u>7</u> miles <u>NE</u> of <u>McBride</u> (distance) (direction) (nearest town)	<u>SAND</u>	<u>55</u>	<u>80</u>
WELL PURPOSE: <u>home</u> (home, irrigation, municipal, industrial)	<u>Clay</u>	<u>80</u>	<u>111</u>
WELL COMPLETION DATA: (1) diameter (inches) <u>2</u> (2) total depth (feet) <u>153</u> (3) static water level (feet) <u>6</u> <u>below</u> top of ground. (4) casing <u>Galv</u> , <u>148</u> , (material) (depth) (size) if telescope see back. (5) screen <u>5'</u> , <u>148</u> (length) (depth to top) <u>2</u> , <u>STAINLESS</u> (size) (material) (6) pump _____ (HP) _____ (yield gpm) (type power) _____ (7) electric log <u>NO</u> (yes or no) (organization running log) _____ (8) how well bottom plugged <u>R.P. Valve</u>	<u>SAND</u>	<u>111</u>	<u>153</u>
DRILLERS REMARKS: <u>Pump installed by owner</u>			

COBED

If well telescopes please sketch and show depths.

GROUND LEVEL

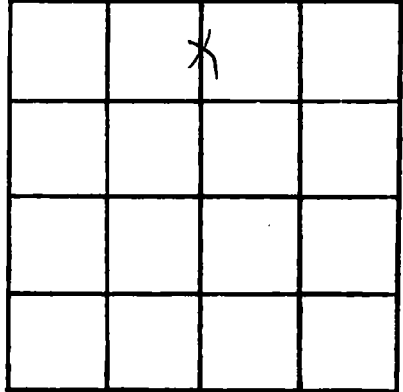

SECTION 6

Please indicate well location X.

ADDITIONAL INFORMATION

If more than one screen, show locations of each on sketch.