

CODED

JACKSON
Q 391
1-15-73

MISSISSIPPI
BOARD OF WATER COMMISSIONERS
416 North State Street
Jackson, Mississippi 39201

WATER WELL DRILLERS LOG

1-15-73 data well completed 23 Bluff Water Supply firm name Jackson county well located

LANDOWNER: Charles Harris
Bayou Cumbert MS (mailing address)

description of formations encountered	from	to
clay	0	10
sand	20	149
clay	149	185
sand	185	258

WELL LOCATION:
sec. 36 T. 7 N. R. 5 E. W. 1
5 miles SE of M.P.
(distance) (direction) (nearest town)

WELL PURPOSE: Home
(home, irrigation, municipal, industrial)

WELL COMPLETION DATA:

(1) diameter (inches) 2

(2) total depth (feet) 258

(3) static water level (feet) 38 below above top of ground.

(4) casing galv. 253 (material) (depth)

(size) If telescope see back.

(5) screen 5' 253 (length) (depth to top)

2" slat (size) (material)

(6) pump 1 10 (HP) (yield gpm)

elct (type power)

(7) electric log no (yes or no)

(organization running log)

(8) how well bottom plugged BP Vibro

CODED


APR 1 1973

MISS. BO. OF WATER COMMISSIONERS

DRILLERS REMARKS:

If well telescopes please sketch and show depths.

GROUND LEVEL

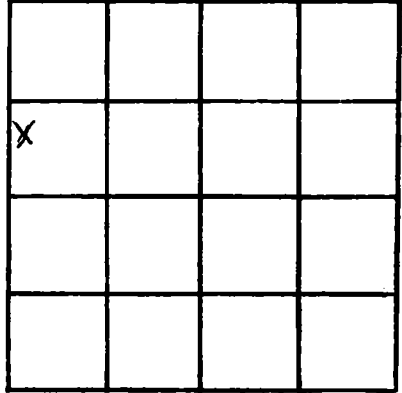

SECTION 36

Please indicate well location X.

ADDITIONAL INFORMATION

If more than one screen,
show locations of each on sketch.