

JACKSON
 Q 397
 11-10-73

MISSISSIPPI
 BOARD OF WATER COMMISSIONERS
 416 North State Street
 Jackson, Mississippi 39201

CODED

WATER WELL DRILLERS LOG

COAST WATER WELL SERVICE

Jackson

11/10 1973
 date well completed


firm name

county well located

LANDOWNER: <u>Regency Wood</u>	description of formations encountered	from	to
<u>P.O. Box 1606</u>	<u>Top Soil</u>	0	15
<u>Pascagoula, Ms</u> (mailing address)	<u>blue clay</u>	15	21
WELL LOCATION:	<u>Coarse Sand</u>	21	86
sec. <u>5</u> T <u>2</u> N R <u>S</u> W <u>in Pascagoula, Ms.</u> (distance) miles (direction) of (nearest town)	<u>gray clay</u>	86	91
WELL PURPOSE: <u>test hole</u> (home, irrigation, municipal, industrial)	<u>Coarse Sand</u>	91	201
WELL COMPLETION DATA:	<u>blue clay</u>	201	240
(1) diameter (inches) <u>3 1/2</u>	<u>Coarse Sand</u>	240	311
(2) total depth (feet) <u>311</u>			
(3) static water level (feet) _____ below top of ground. _____ above			
(4) casing _____ (material), _____ (depth), _____ (size) if telescope see back.			
(5) screen _____ (length), _____ (depth to top), _____ (size), _____ (material)			
(6) pump _____ (HP), _____ (yield gpm), _____ (type power)			
(7) electric log <u>NO</u> (yes or no)			
_____ (organization running log)			
(8) how well bottom plugged _____			
DRILLERS REMARKS:			

If well telescopes please sketch and show depths.

GROUND LEVEL

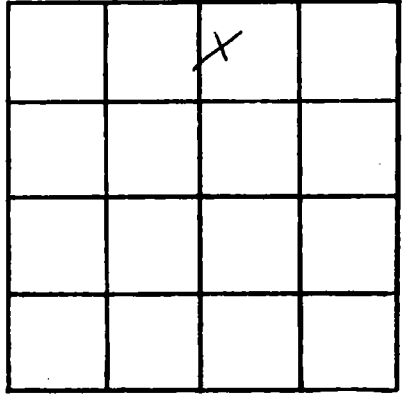

SECTION 5

Please indicate well location X.

ADDITIONAL INFORMATION

If more than one screen, show locations of each on sketch.