

JACKSON
 Q 398
 4-28-73

MISSISSIPPI
 BOARD OF WATER COMMISSIONERS
 416 North State Street
 Jackson, Mississippi 39201

CODED

WATER WELL DRILLERS LOG

4-28 1973 data well completed
 Solid Water Supply firm name
 Jackson county well located


| LANDOWNER: | description of formations encountered: | from | to |
|---|--|-----------------|-------------------|
| Clarence M ^{rs} Cornack | | 0 | 6 |
| Orange Grove M ^{rs} (mailing address) | sandy clay sand clay sand | 6 174 195 | 174 195 265 |
| <p>WELL LOCATION:</p> <p>sec 23 T 7 N R 5 E 4 miles East of Kneek (distance) (direction) (nearest town)</p> | | | |
| <p>WELL PURPOSE: <u>Home</u> (home, irrigation, municipal, industrial)</p> | | | |
| <p>WELL COMPLETION DATA:</p> <p>(1) diameter (inches) <u>2"</u></p> <p>(2) total depth (feet) <u>265</u></p> <p>(3) static water level (feet) <u>25 1/2</u> below above top of ground.</p> <p>(4) casing <u>galv.</u> <u>260</u> (material) (depth) (size) if telescope see back.</p> <p>(5) screen <u>5'</u> <u>260</u> (length) (depth to top) <u>2"</u> <u>stainless</u> (size) (material)</p> <p>(6) pump <u>1</u> <u>10</u> (HP) (yield gpm) <u>dia</u> (type power)</p> <p>(7) electric log <u>no</u> (yes or no) (organization running log)</p> <p>(8) how well bottom plugged <u>BP Valve</u></p> | | | |
| <p>DRILLERS REMARKS:</p> | | | |

CODED

REV 24 1073
 DEU 21 1073

If well telescopes please sketch and show depths.

GROUND LEVEL

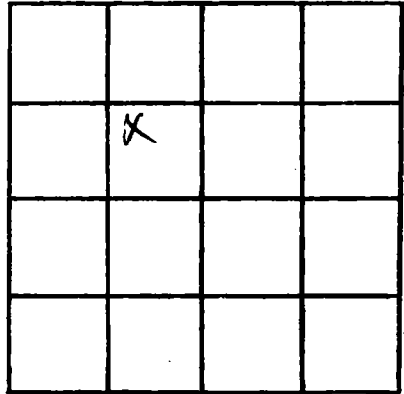

SECTION 23

Please indicate well location X.

ADDITIONAL INFORMATION

If more than one screen, show locations of each on sketch.