

JACKSON
 Q 399
 5-12-73

MISSISSIPPI
 BOARD OF WATER COMMISSIONERS
 416 North State Street
 Jackson, Mississippi 39201

CODED

WATER WELL DRILLERS LOG

5-12 data well completed 1973 Carroll Water Supply firm name Jackson county well located


LANDOWNER: <u>Butch</u>	description of formations encountered	from	to
<u>Alitch</u>			
<u>Orange Grove Ms.</u> (mailing address)	<u>Sandy clay</u>	<u>0</u>	<u>6</u>
WELL LOCATION: sec. <u>23</u> T. <u>7</u> N. R. <u>5</u> E	<u>Sand</u>	<u>6</u>	<u>174</u>
<u>4</u> miles <u>east</u> of <u>Kresle</u> (distance) (direction) (nearest town)	<u>clay</u>	<u>174</u>	<u>194</u>
WELL PURPOSE: <u>home</u> (home, irrigation, municipal, industrial)	<u>sand</u>	<u>194</u>	<u>237</u>
WELL COMPLETION DATA:			
(1) diameter (inches) <u>2</u>			
(2) total depth (feet) <u>237</u>			
(3) static water level (feet) <u>26 1/2</u> <u>below</u> above top of ground.			
(4) casing <u>galv</u> , <u>232</u> (material) (depth)			
(size) if telescope see back.			
(5) screen <u>5</u> , <u>232</u> (length) (depth to top)			
<u>2</u> , <u>stain</u> (size) (material)			
(6) pump <u>1</u> , <u>10</u> (HP) (yield gpm)			
<u>elec</u> (type power)			
(7) electric log <u>no</u> (yes or no)			
(organization running log)			
(8) how well bottom plugged <u>BP Valve</u>			
DRILLERS REMARKS:			

CODED

DEC 21 1973

If well telescopes please sketch and show depths.

GROUND LEVEL

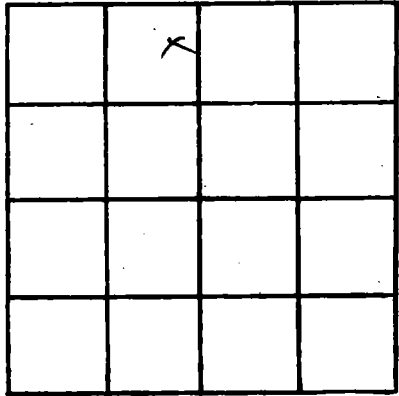

SECTION 23

Please indicate well location X.

ADDITIONAL INFORMATION

If more than one screen, show locations of each on sketch.