

JACKSON  
Q 400  
4-14-73

MISSISSIPPI  
BOARD OF WATER COMMISSIONERS  
416 North State Street  
Jackson, Mississippi 39201

CODED

WATER WELL DRILLERS LOG

4-14 1973 data well completed  
 B.P. Valve firm name  
 Jackson county well located

LANDOWNER: Jerry  
 Nicholas  
 Orange Grove Mrs.  
 (mailing address)

description of formations encountered	from	to
clay	0	21
sand	21	27
clay	27	69
sand	69	72
clay	72	132
sand	132	153

WELL LOCATION:  
 sec. 31 T. 7 N. R. 4 E  
 7 miles NE of Moss Point  
 (distance) (direction) (nearest town)

WELL PURPOSE: domestic  
 (home, irrigation, municipal, industrial)

WELL COMPLETION DATA:

(1) diameter (inches) 2

(2) total depth (feet) 153

(3) static water level (feet) 1'-6" below above top of ground.

(4) casing galv. 148 (material), (depth)

(size) if telescope see back.

(5) screen 5' 148 (length), (depth to top)

2" stainless (size), (material)

(6) pump 1 12 (HP), (yield gpm)

colp (type power)

(7) electric log no (yes or no)

(organization running log)


(8) how well bottom plugged B.P. Valve

CODED

DRILLERS REMARKS:

If well telescopes please sketch and show depths.

GROUND LEVEL

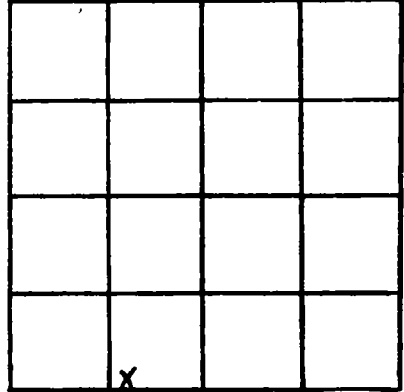

SECTION 31

Please indicate well location X.

ADDITIONAL INFORMATION

If more than one screen, show locations of each on sketch.