

JACKSON
Q 402
11-16-73

MISSISSIPPI **CODED**
BOARD OF WATER COMMISSIONERS
416 North State Street
Jackson, Mississippi 39201

WATER WELL DRILLERS LOG

Nov 16 1973 Chick Water Supply Jackson
date well completed firm name county well located

LANDOWNER:	description of formations encountered	from	to
<u>John M^c Donald</u> <u>Orange Grove MS.</u> (mailing address)			

WELL LOCATION:
sec 23 T 7 N R 5 E
5 miles East of M.P.
(distance) (direction) (nearest town)

CODED

WELL PURPOSE: Home
(home, irrigation, municipal, industrial)

WELL COMPLETION DATA:

(1) diameter (inches) 2

(2) total depth (feet) 236

(3) static water level (feet) 25 below top of ground.

(4) casing galv 231
(material) (depth)

(size) If telescope see back.

(5) screen 5' 231
(length) (depth to top)

2" stainless
(size) (material)

(6) pump 1 15
(HP) (yield gpm)

elec
(type power)

(7) electric log no
(yes or no)


(organization running log)

(8) how well bottom plugged BP Value

DRILLERS REMARKS:

If well telescopes please sketch and show depths.

GROUND LEVEL

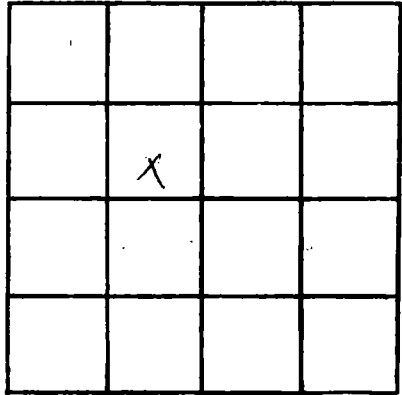

SECTION 23

Please indicate well location X.

ADDITIONAL INFORMATION

If more than one screen, show locations of each on sketch.