

Jackson
Q 405
11-16-73

MISSISSIPPI
BOARD OF WATER COMMISSIONERS
416 North State Street
Jackson, Mississippi 39201

CODED

WATER WELL DRILLERS LOG

Nov 16 1973 Colwell Water Sys Jackson
date well completed firm name county well located

LANDOWNER: John M^o Donald
Orange Grove Mrs.
(mailing address)

description of formations encountered	from	to
	Clay	0
sand	15	195
Clay	195	205
sand	205	250

WELL LOCATION:
sec. 23 T. 7 N. R. 5 E
6 miles East of M.P.
(distance) (direction) (nearest town)

WELL PURPOSE: Home
(home, irrigation, municipal, industrial)

WELL COMPLETION DATA:

(1) diameter (inches) 2

(2) total depth (feet) 250

(3) static water level (feet) 30 ^{below} above top of ground.

(4) casing Galv 245
(material) (depth)

(size) if telescope see back.

(5) screen 5' 245
(length) (depth to top)

2 Stainless
(size) (material)

(6) pump 1 15
(HP) (yield gpm)


elec
(type power)

(7) electric log no
(yes or no)

(organization running log)

(8) how well bottom plugged BP
Value

CODED

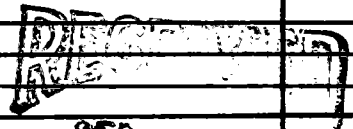


SEP 8 1974

DRILLERS REMARKS:

If well telescopes please sketch and show depths.

GROUND LEVEL

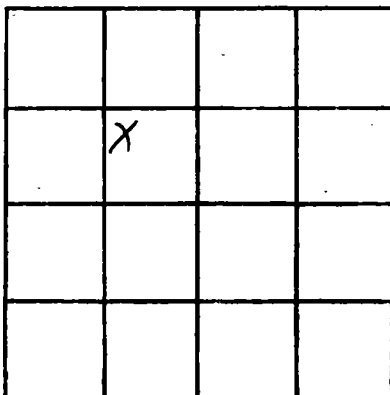

SECTION 23

Please indicate well location X.

ADDITIONAL INFORMATION

If more than one screen, show locations of each on sketch.