

JACKSON
Q 406
9-24-73

MISSISSIPPI
BOARD OF WATER COMMISSIONERS
416 North State Street
Jackson, Mississippi 39201

CODED

WATER WELL DRILLERS LOG

Sept 24 1973 Cobille Water Sup Jackson
date well completed firm name county well located

LANDOWNER:	description of formations encountered	from	to
Willard			
Rice			
Kreole ms	Clay	2	10
(mailing address)	sand	10	21
	Clay	21	110
	sand	110	173
	Clay	173	215
	sand	215	263

WELL LOCATION:
sec. 28 2 N R 5 E
1 miles East of M.P.
(distance) (direction) (nearest town)

WELL PURPOSE: Home
(home, irrigation, municipal, industrial)

WELL COMPLETION DATA:

(1) diameter (inches) 2

(2) total depth (feet) 263

(3) static water level (feet) 32 below top of ground

(4) casing galv 258
(material) (depth)

(size) If telescope see back.

(5) screen 5 258
(length) (depth to top)

2 stainless
(size) (material)

(6) pump 1 1/2 15
(HP) (yield gpm)


abc
(type power)

(7) electric log no
(yes or no)

(organization running log)

(8) how well bottom plugged B.P. Value

CODED

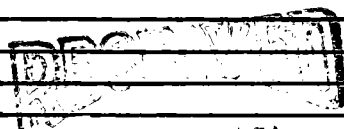


SEP 30 1974

DRILLERS REMARKS:

MISS. BD. OF WATER COMM.

If well telescopes please
sketch and show depths.

GROUND LEVEL

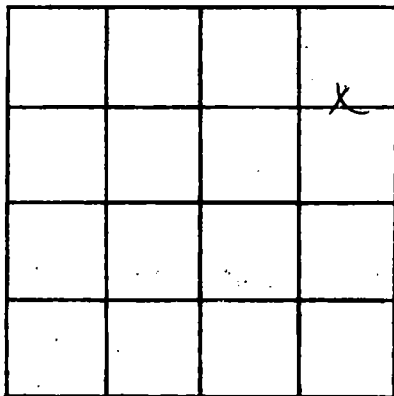

SECTION 28

Please indicate well location X.

ADDITIONAL INFORMATION

If more than one screen,
show locations of each on sketch.