

Q 410  
 Jackson  
 5/5/75

MISSISSIPPI  
 BOARD OF WATER COMMISSIONERS  
 416 North State Street  
 Jackson, Mississippi 39201

CODED

WATER WELL DRILLERS LOG

May 5 1975 Colville Water Exp. Jackson  
 date well completed firm name county well located

LANDOWNER: Woodrow  
Partis  
Bayou Couvent Ms  
 (mailing address)

description of formations encountered	from	to
<u>clay</u>	<u>0</u>	<u>15</u>
<u>sand</u>	<u>15</u>	<u>154</u>
<u>clay</u>	<u>154</u>	<u>220</u>
<u>sand</u>	<u>220</u>	<u>246</u>

WELL LOCATION:  
 sec 36 T 2 N R 5 E  
9 1/4 miles N of McL.  
 (distance) (direction) (nearest town)

WELL PURPOSE: hart shoe  
 (home, irrigation, municipal, industrial)

- WELL COMPLETION DATA:
- (1) diameter (inches) 2
  - (2) total depth (feet) 246
  - (3) static water level (feet) 37 below top of ground above
  - (4) casing plastic 241  
 (material) (depth)
  - (size) if telescope see back.
  - (5) screen 5 241  
 (length) (depth to top)
  - 2" plastic  
 (size) (material)
  - (6) pump 1 15  
 (HP) (yield gpm)
  - elec  
 (type power)
  - (7) electric log no  
 (yes or no)

CODED

(organization running log)

(8) how well bottom plugged B.P. Vah

RECEIVED


JUN 5 1975

DRILLERS REMARKS:

MISSISSIPPI BOARD OF WATER COMMISSIONERS

If well telescopes please sketch and show depths.

GROUND LEVEL

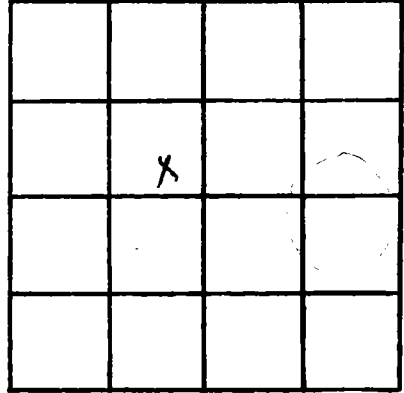

SECTION *36*

Please indicate well location X.

ADDITIONAL INFORMATION

If more than one screen,  
show locations of each on sketch.