

Q 411  
 Jackson  
 4/6/75

MISSISSIPPI  
 BOARD OF WATER COMMISSIONERS  
 416 North State Street  
 Jackson, Mississippi 39201 **CODED**

WATER WELL DRILLERS LOG

April 6 1975 *Cephile water supply Jackson*  
 date well completed firm name county well located

LANDOWNER: *Dr. Paul Morris*  
*Franklin Creek MS.*  
 (mailing address)

description of formations encountered	from	to
<i>clay</i>	<i>0</i>	<i>10</i>
<i>sand</i>	<i>10</i>	<i>88</i>
<i>clay</i>	<i>88</i>	<i>125</i>
<i>sand</i>	<i>125</i>	<i>142</i>

WELL LOCATION:  
 sec. *7* T. *2* N. R. *5* E. W. *1*  
*2 3/4* miles *NE* of *MP.*  
 (distance) (direction) (nearest town)

WELL PURPOSE: *home*  
 (home, irrigation, municipal, industrial)

- WELL COMPLETION DATA:
- (1) diameter (inches) *2"*
  - (2) total depth (feet) *142*
  - (3) static water level (feet) *5* <sup>below</sup> <sub>above</sub> top of ground.
  - (4) casing *plastic 147'*  
 (material) (depth)  
 (size) if telescope see back.
  - (5) screen *5'* *147'*  
 (length) (depth to top)  
*2'* *plastic*  
 (size) (material)
  - (6) pump \_\_\_\_\_ (HP) \_\_\_\_\_ (yield gpm)  
 (type power)
  - (7) electric log *no*  
 (yes or no)  
 (organization running log)
  - (8) how well bottom plugged *BPL*

**CODED**


**RECEIVED**  
 JUN 1975

DRILLERS REMARKS: *plastic installed by owner*

MISS. Bd. \_\_\_\_\_

If well telescopes please sketch and show depths.

GROUND LEVEL

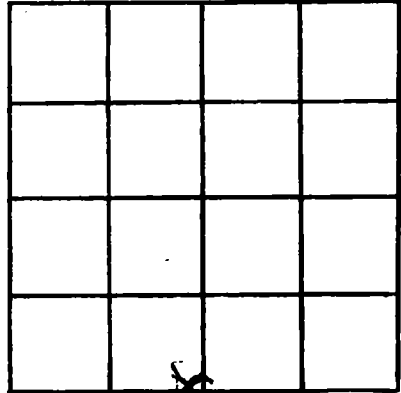

SECTION   R  

Please indicate well location X.

ADDITIONAL INFORMATION

If more than one screen, show locations of each on sketch.