

Q 412
 Jackson
 9/14/74

MISSISSIPPI
 BOARD OF WATER COMMISSIONERS
 416 North State Street
 Jackson, Mississippi 39201

CODED

WATER WELL DRILLERS LOG

Sept 14 1974 24 Cahill Water Div. Jackson
 date well completed firm name county well located

LANDOWNER: Robert Brown
 Pecan Ms
 (mailing address)


WELL LOCATION:
 sec. 7 T. 7 N. R. 4 E.
 8.31 miles S of M.P.
 (distance) (direction) (nearest town)

WELL PURPOSE: pond
 (home, irrigation, municipal, industrial)

WELL COMPLETION DATA:
 (1) diameter (inches) 4
 (2) total depth (feet) 205
 (3) static water level (feet) 4 below top of ground.
 (4) casing plastic 195 (material) (depth)
 (size) if telescope see back.
 (5) screen 10 195 (length) (depth to top)
 4 1/4 plastic (size) (material)
 (6) pump (HP) (yield gpm)
 (type power)
 (7) electric log no (yes or no)
 (organization running log)
 (8) how well bottom plugged Bp Valve

description of formations encountered	from	to
clay	0	25
sand	25	80
Clay	80	102
sand	102	122
Coar	122	180
sand	180	205

CODED

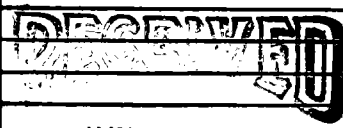


JUN 5 1974

DRILLERS REMARKS: Pump installed by owner

OF WATER COMMISSIONERS

If well telescopes please sketch and show depths.

GROUND LEVEL

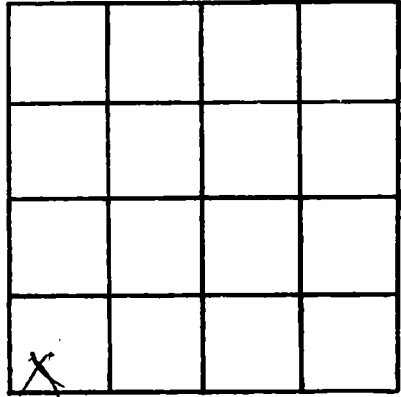

SECTION 7

Please indicate well location X.

ADDITIONAL INFORMATION

If more than one screen, show locations of each on sketch.