

Q 413
 Jackson
 8/16/74

MISSISSIPPI
 BOARD OF WATER COMMISSIONERS
 416 North State Street
 Jackson, Mississippi 39201

CODED

WATER WELL DRILLERS LOG

Aug 16 1974 Colville Water Sup Jackson
 day well completed firm name county well located

LANDOWNER: Duron
 Parks
 Orange Grove Ms
 (mailing address)

description of formations encountered	from	to
Clay	0	18
Sand	18	240
Clay	240	265
Sand	265	288
Clay	288	305
Sand	305	318

WELL LOCATION:
 sec. 13 T. 7 N R. 5 E
 4.3 miles NE of M.P.
 (distance) (direction) (nearest town)

WELL PURPOSE: Home
 (home, irrigation, municipal, industrial)

CODED

WELL COMPLETION DATA:

(1) diameter (inches) 2 1/8"
 (2) total depth (feet) 318
 (3) static water level (feet) 28 ^{below}/_{above} top of ground.
 (4) casing plastic 2 1/8
 (material) (depth)
 (size) if telescope see back.
 (5) screen 5 3/8
 (length) (depth to top)
 2 plastic
 (size) (material)
 (6) pump 1 1/2
 (HP) (yield gpm)
 elec
 (type power)
 (7) electric log no
 (yes or no)
 (organization running log)
 (8) how well bottom plugged BP/above


RECEIVED
 JUN 7 1975

DRILLERS REMARKS:

MISS. BD. OF WATER COMMISSIONERS

If well telescopes please sketch and show depths.

GROUND LEVEL

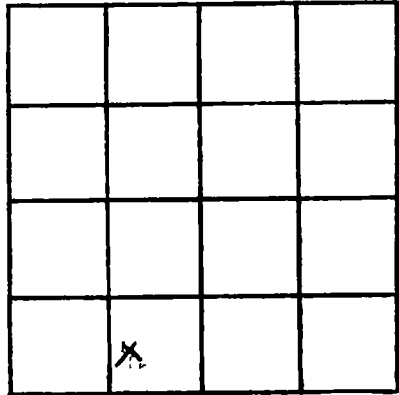

SECTION 13

Please indicate well location X.

ADDITIONAL INFORMATION

If more than one screen, show locations of each on sketch.