

Jackson
 Q 416
 12/14/74

MISSISSIPPI
 BOARD OF WATER COMMISSIONERS
 416 North State Street
 Jackson, Mississippi 39201

WATER WELL DRILLERS LOG


12/14 1974 COAST WATER WELL SERVICE Jackson
 date well completed firm name county well located

LANDOWNER: <u>Phil Bascage</u>	description of formations encountered		from	to
<u>Rt. 1 Box 325 MS</u>	<u>top soil</u>		<u>0</u>	<u>10</u>
<u>Passapatanz Ms.</u> (mailing address)	<u>Blue Clay</u>		<u>10</u>	<u>18</u>
WELL LOCATION: sec. <u>23</u> T. <u>7</u> S. R. <u>5</u> W.	<u>coarse sand + gravel</u>		<u>18</u>	<u>135</u>
<u>3</u> miles <u>East</u> of <u>Neale</u> (distance) (direction) (nearest town)	<u>Blue Clay</u>		<u>135</u>	<u>161</u>
WELL PURPOSE: <u>Home</u> (home, irrigation, municipal, industrial)	<u>coarse sand</u>		<u>161</u>	<u>250</u>
WELL COMPLETION DATA: (1) diameter (inches) <u>2"</u>				
(2) total depth (feet) <u>250'</u>				
(3) static water level (feet) <u>25</u> below top of ground				
(4) casing <u>PVC</u> <u>240'</u> (material) (depth)				
<u>2"</u> if telescope see back. (size)				
(5) screen <u>10'</u> <u>240'</u> (length) (depth to top)				
<u>2"</u> <u>PVC</u> (size) (material)				
(6) pump <u>1</u> <u>10</u> (HP) (yield gpm)				
<u>elec.</u> (type power)				
(7) electric log <u>NO</u> (yes or no)				
<u></u> (organization running log)				
(8) how well bottom plugged <u>B. 76. 76.</u>				
DRILLERS REMARKS:				

OCT 22 1974
 MISS. RD. OF WATER COMMISSIONERS

If well telescopes please sketch and show depths.

GROUND LEVEL

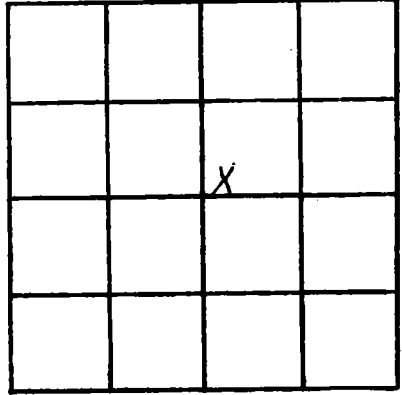

SECTION 23

Please indicate well location X.

ADDITIONAL INFORMATION

If more than one screen, show locations of each on sketch.