

JACKSON  
 418  
 3-15-76

MISSISSIPPI  
 BOARD OF WATER COMMISSIONERS  
 416 North State Street  
 Jackson, Mississippi 39201

#  
 2  
 CODED  
 L

WATER WELL DRILLERS LOG

MARCH 15 1976 Holland Wells  
 date well completed firm name  
 Mobile, ALA

JACKSON  
 county well located

LANDOWNER:  
 ESCATAWA SUBURBAN  
 UTILITY DISTRICT (ESCATAWA MS.)  
 (mailing address)

description of formations encountered	from	to
CLAY	0	10
SAND	10	140
CLAY	140	147
SAND	147	184
CLAY (SOFT TO HARD)	184	300
SAND	300	303
CLAY	303	310
SAND	310	312
CLAY	312	319
Light Chattering SAND	319	321
Heavy Chattering Sand	321	348
Light " "	348	350
CLAY	351	
CODED		

WELL LOCATION:  
 sec. 18 T. 7 R. 5  
 S W  
 IN ESCATAWA  
 miles of (nearest town)  
 (distance) (direction)

WELL PURPOSE:  
 (home, irrigation, municipal, industrial)

WELL COMPLETION DATA:  
 (1) diameter (inches) 10  
 (2) total depth (feet) 350'  
 (3) static water level (feet) 58' below top of ground.  
 (4) casing BLK Steel, 320' (material) (depth)  
 (size) if telescope see back.  
 (5) screen 25' 330' (length) (depth to top)  
 6" 5.S. GRAVEL WALL (size) (material)  
 (6) pump 15 250 (HP) (yield gpm)  
 elec (type power)  
 (7) electric log NO (yes or no)  
 (organization running log)

(8) how well bottom plugged WASH VALVE


MAY - 3 1976

DRILLERS REMARKS:  
 Replacement wells

MISS. BD. OF WATER COMM

If well telescopes please sketch and show depths.

GROUND LEVEL

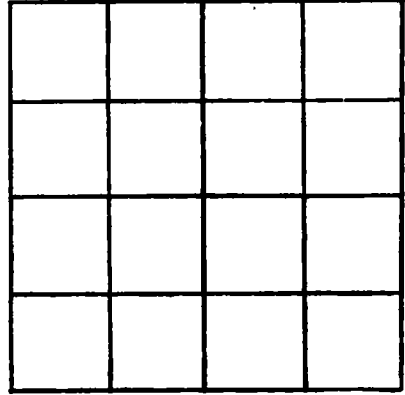

SECTION \_\_\_\_\_

Please indicate well location X.

ADDITIONAL INFORMATION

If more than one screen, show locations of each on sketch.