

MISSISSIPPI  
BOARD OF WATER COMMISSIONERS  
416 North State Street  
Jackson, Mississippi 39201

#  
3  
Well  
CODED

JACKSON  
419  
3-9-76

WATER WELL DRILLERS LOG

CODED

MARCH 1 1976 Holland Well Co JACKSON  
date well completed Mobile, AL county well located

LANDOWNER:  
ESCATAWPA Suburban  
Utility District (ESCATAWPA  
Ms.  
(mailing address)


description of formations encountered	depth	
	from	to
CLAY	0	40
SAND	40	107
Rock	107	
CLAY	108	137
<del>HARD CLAY</del> SAND	137	172
HARD CLAY	172	320
SAND	320	336
CLAY	336	340
CLAY	340	362
Light Chattering SAND	362	380
Good " "	380	417

WELL LOCATION:  
sec. 18 T 7 S R. 5 E  
1/2 miles ESCATAWPA  
(distance) (direction) of (nearest town)

WELL PURPOSE:  
(home, irrigation, municipal, industrial)

- WELL COMPLETION DATA:
- (1) diameter (inches) 10
  - (2) total depth (feet) 417
  - (3) static water level (feet) 49 below above top of ground.
  - (4) casing B/K Steel 365'  
(material) (depth)  
(size) if telescope see back.
  - (5) screen 50 367  
(length) (depth to top)  
6" SS  
(size) (material)
  - (6) pump 15 250  
(HP) (yield gpm)  
elec  
(type power)
  - (7) electric log NO  
(yes or no)  
(organization running log)
  - (8) how well bottom plugged WASH VALVE

CODED

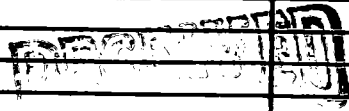

MAY 9 1976

DRILLERS REMARKS:  
Replacement well

BOARD OF WATER COMMISSIONERS

If well telescopes please sketch and show depths.

GROUND LEVEL


SECTION \_\_\_\_\_

Please indicate well location X.

ADDITIONAL INFORMATION

If more than one screen, show locations of each on sketch.