

MISSISSIPPI DEPARTMENT OF NATURAL RESOURCES

Bureau of Land and Water Resources

Southport Mall

P.O. Box 10631

Jackson, Mississippi 39209

CODED

WATER WELL DRILLERS LOG

JACKSON
Q 425
3-24-81
3-24-

date well completed 3-24- firm name 81 Coast Water Well Serv. Inc. Jackson county well located Jackson

LANDOWNER William A. Burk
1666 Cheshire Dr. W.
Mobile, Ala 36605
(mailing address)

description of formations encountered	from	to
<u>Top soil</u>	<u>0</u>	<u>3'</u>
<u>Blue Clay</u>	<u>3</u>	<u>30'</u>

WELL LOCATION:
sec. 27 T. 7N R. 5E
S. W. 3 miles SE of Mass Point
(distance) (direction) (nearest town)

<u>White Coarse sand & Wood</u>	<u>30'</u>	<u>69'</u>
<u>Blue Clay & Wood</u>	<u>69'</u>	<u>96'</u>

WELL PURPOSE: None
(home, irrigation, municipal, industrial)

<u>Gray Coarse sand & Wood</u>	<u>96'</u>	<u>124'</u>
------------------------------------	------------	-------------

WELL COMPLETION DATA:

- (1) diameter (inches) 2"
- (2) total depth (feet) 270'
- (3) static water level (feet) 42' below top of ground
- (4) casing PVC 260'
(material) (depth)
- (5) screen 2" if telescope see back.
(size) 10' 260'
(length) (depth to top)
- (6) pump 1/2 HP PVC
(HP) (material) 11 1/2
(yield gpm)
- (7) electric log No.
(yes or no)

<u>Gray Coarse sand & Wood & gravel</u>	<u>124'</u>	<u>144'</u>
<u>Blue Clay</u>	<u>144'</u>	<u>195'</u>
<u>Gray Coarse sand</u>	<u>195'</u>	<u>270'</u>

(organization running log)

(8) Is well bottom plugged? No.
Back Wash Valve

DRILLERS REMARKS:

DEPT. OF NATURAL RESOURCES
BUREAU OF LAND & WATER RESOURCES


APR - 9 1981

RECEIVED

If well telescopes please sketch and show depths.

03000

GROUND LEVEL

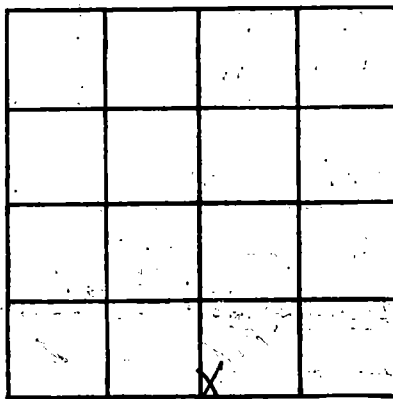

SECTION 27

Please indicate well location X.

ADDITIONAL INFORMATION

If more than one screen,
show locations of each on sketch.