

MISSISSIPPI DEPARTMENT OF NATURAL RESOURCES

Bureau of Land and Water Resources

Southport Mall

P.O. Box 10631

Jackson, Mississippi 39209

CODED

WATER WELL DRILLERS LOG

JACKSON
Q 426
7-25-81
3-25-81

date well completed

firm name

county well located

Coast Water Well Serv. Jackson

LANDOWNER

John James

description of formations encountered

from

to

Box 1148

Top soil

0 3'

Pascagoula Miss.
(mailing address)

Red Clay

3' 22'

WELL LOCATION:

sec. 36 T. 7 N. S. R. 5 E. W.

Red Coarse sand

22' 60'

5 1/2 miles ENE of PASCAGOULA
(distance) (direction) (nearest town)

Blue Clay

60' 80'

WELL PURPOSE:

(home, irrigation, municipal, industrial)

Home

White Coarse sand

80' 155'

WELL COMPLETION DATA:

Blue Clay

155' 205'

(1) diameter (inches) 2"

Gray Coarse sand

205' 290'

(2) total depth (feet) 290'

(3) static water level (feet) 37' below top of ground.

(4) casing PDC 280'
(material) (depth)

2" if telescope see back.
(size)

(5) screen 10' 280'
(length) (depth to top)

2" PDC
(size) (material)

(6) pump 1/2 h.p. 12 1/2
(HP) (yield gpm)

Electric
(type power)

(7) electric log No.
(yes or no)

(organization running log)

(8) how well bottom plugged
Back Wash Valve

DRILLERS REMARKS:

DEPT. OF NATURAL RESOURCES
BUREAU OF LAND & WATER RESOURCES


APR - 9 1981

RECEIVED

If well telescopes please sketch and show depths.

1700

GROUND LEVEL

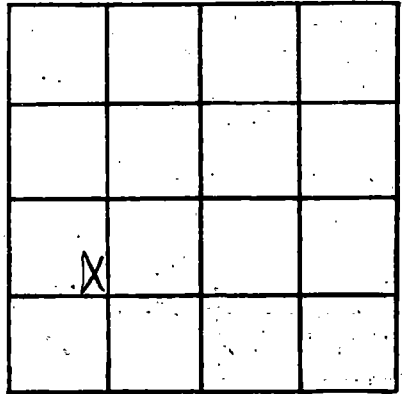

SECTION 36

Please indicate well location X.

ADDITIONAL INFORMATION

If more than one screen, show locations of each on sketch.