

MISSISSIPPI DEPARTMENT OF NATURAL RESOURCES

Bureau of Land and Water Resources

Southport Mall

P.O. Box 10631

CODED

Jackson, Mississippi 39209

WATER WELL DRILLERS LOG

JACKSON
Q428
6-9-81

6-9-81 19 Coast Water Well Sew. Inc. Jackson
date well completed firm name county well located

LANDOWNER: Shaw & Root
Industrial Road
Pascagoula Miss.
(mailing address) 39567

description of formations encountered	from	to
<u>Top soil</u>	<u>0</u>	<u>3'</u>
<u>Blue clay</u>	<u>3'</u>	<u>120'</u>
<u>Gray coarse sand</u>		
<u>and gravel</u>	<u>120'</u>	<u>215'</u>

WELL LOCATION:
sec. 20 T. 8 N. R. 5 W.
3 miles SE of PASCOGOLA
(distance) (direction) (nearest town)


WELL PURPOSE: Indus.
(home, irrigation, municipal, industrial)

- WELL COMPLETION DATA:
- (1) diameter (inches) 6"
 - (2) total depth (feet) 215'
 - (3) static water level (feet) 45' below above top of ground.
 - (4) casing PVC 195'
(material) (depth)
6" If telescope see back.
(size)
 - (5) screen 20' 195'
(length) (depth to top)
6" PVC
(size) (material)
 - (6) pump 1 1/2 hp 175
(HP) (yield gpm)
Electric
(type power)
 - (7) electric log No.
(yes or no)
- (organization running log)

(8) how well bottom plugged
Back Wash Valve

DRILLERS REMARKS:

CODED

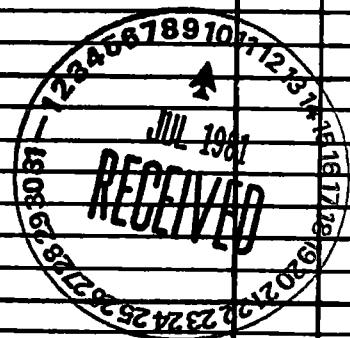

If well telescopes please sketch and show depths.

GROUND LEVEL

			X

SECTION 20

Please indicate well location X.

ADDITIONAL INFORMATION

If more than one screen, show locations of each on sketch.

