

JACKSON  
 429  
 3/16/83

MISSISSIPPI  
 BOARD OF WATER COMMISSIONERS  
 416 North State Street  
 Jackson, Mississippi 39201  
 WATER WELL DRILLERS LOG

CODED

3/16 19 83 Layne-Central Company Jackson  
 date well completed firm name county well located

LANDOWNER: MS. State Highway

description of formations encountered

from

to

Department. (Gregory)

sand

0

10

Constructors - I-10 Welcom

clay

10

14

Station (mailing address)

sand

14

19

WELL LOCATION:

clay

19

36

sec. 32 T 7S N R 4W E S W

sand and pea gravel

36

105

clay and sand

105

116

clay

116

156

(distance) miles (direction) of (nearest town)

sandy clay

156

162

WELL PURPOSE: municipality (home, irrigation, municipal, industrial)

sand and logs

162

185

clay

185

198

WELL COMPLETION DATA:

sand and clay stks.

198

272

(1) diameter (inches) 6"

clay

272

367

(2) total depth (feet) 565'

sand

367

373

(3) static water level (feet) Flow log top of ground.

clay and sand stks.

373

518

(4) casing steel 510' (material) (depth)

sand

518

564

6" (size) If telescope see back.

clay

564

567

(5) screen 40'8" 510' (length) (depth to top)

4" Stainless Steel (size) (material)

(6) pump 7 1/2 100 (HP) (yield gpm)

electric (type power)

(7) electric log yes (yes or no)

MS Geo. Survey (organization running log)

(8) how well bottom plugged W. R.

DRILLERS REMARKS:


OFFICE OF NATURAL RESOURCES  
 MISSISSIPPI DEPARTMENT OF LAND & WATER RESOURCES

MAR 29 1983

RECEIVED

If well telescopes please sketch and show depths.

GROUND LEVEL

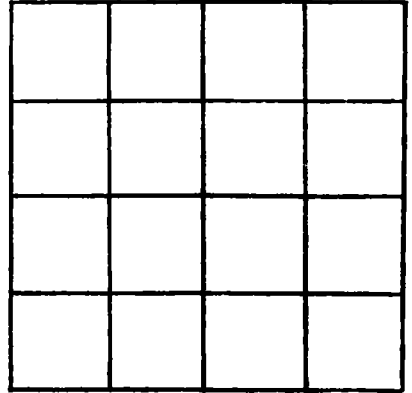

SECTION \_\_\_\_\_

Please indicate well location X.

ADDITIONAL INFORMATION

Lined area for additional information.

If more than one screen, show locations of each on sketch.