

MISSISSIPPI DEPARTMENT OF NATURAL RESOURCES
 Bureau of Land and Water Resources
 Southport Mall
 P.O. Box 10631
 Jackson, Mississippi 39209
WATER WELL DRILLERS LOG

JACKSON
 430
 9/12/83

SEP 12 1983 2 RIVER DRILLING SERVICE JACKSON
 date well completed firm name county well located

LANDOWNER: MISSISSIPPI STATE HIGHWAY DEPT - I-10
TRUCK SALES - EAST LANE
 (mailing address)

WELL LOCATION: SOUTH SEA
 sec. 1 T. 7 N. R. 5 E.
 (distance) miles (direction) of (nearest town)

WELL PURPOSE: TRUCK SALES
 (home, irrigation, municipal, industrial)

- WELL COMPLETION DATA:
- (1) diameter (inches) 6x4
 - (2) total depth (feet) 577
 - (3) static water level (feet) 12 ^{below} ~~above~~ top of ground.
 - (4) casing Steel 6"-42' 4"-492'
 (material) (depth)
6x4" if telescope see back.
 (size)
 - (5) screen 30 547
 (length) (depth to top)
2 1/2" 304S.S. (108)
 (size) (material)
 - (6) pump 2 25
 (HP) (yield gpm)
Elvet.
 (type power)
 - (7) electric log Yes
 (yes or no)
Miss. Geol. Survey
 (organization running log)
 - (8) how well bottom plugged BACK WASH
VALVE

description of formations encountered	from	to
Top Soil	0	3
SAND + CLAY STRATA	3	30
SAND	30	50
CLAY	50	94
SAND w/CLAY STRATA	94	130
CLAY	130	160
SAND	160	180
CLAY	180	190
SAND	190	210
CLAY	210	290
SAND, MEDIUM	290	574
CLAY + SAND STRATA	574	573
Clay	573	603

DEPT. OF NATURAL RESOURCES
 BUREAU OF LAND & WATER RESOURCES


SEP 24 1984

RECEIVED

DRILLERS REMARKS:

If well telescopes please sketch and show depths.

GROUND LEVEL

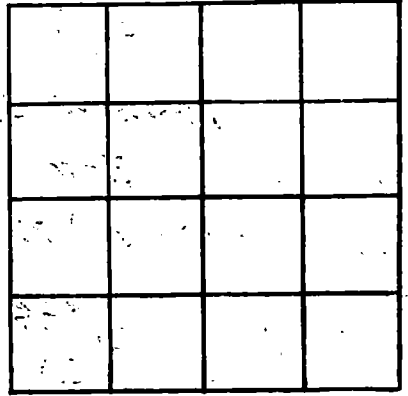

SECTION _____

Please indicate well location X.

ADDITIONAL INFORMATION

If more than one screen, show locations of each on sketch.