

MISSISSIPPI DEPARTMENT OF NATURAL RESOURCES
 Bureau of Land and Water Resources
 Southport Mall
 P.O. Box 10631
 Jackson, Mississippi 39209
WATER WELL DRILLERS LOG

CODED

JACKSON
 0431
 9/12/83

~~2000~~ 12-12-83 GRIMMER DRILLING CO. JACKSON
 date well completed firm name county well located

LANDOWNER: MISSISSIPPI STATE
 HIGHWAY DEPT. - TRUCK
 SCALES - WEST LANE
 (mailing address)

description of formations encountered	from	to
TOP SOIL	0	3
CLAY + SAND streaks	3	10
CLAY	10	99
SAND	92	184
CLAY	184	342
SAND, medium	342	447
CLAY	447	610

WELL LOCATION: N
 sec 5 T 7 N R 4 E
 (distance) miles (direction) of (nearest town)

WELL PURPOSE: TRUCK SCALES
 (home, irrigation, municipal, industrial)

CODED

- WELL COMPLETION DATA:
- (1) diameter (inches) 6x4
 - (2) total depth (feet) 403
 - (3) static water level (feet) 75 below top of ground
 - (4) casing steel 6" 42 ft (material) (depth) 4" 318
 - 6x4 (size) If telescope see back.
 - (5) screen 30 373 (length) (depth to top)
 2 1/2 304 S.S. (.008) (size) (material)
 - (6) pump 2 25 (HP) (yield gpm)
 ELECT (type power)
 - (7) electric log Y2 (yes or no)
 Miss. Geol. Survey (organization running log)
 - (8) how well bottom plugged BACK

318
 42/0
 36

DEPT. OF NATURAL RESOURCES
 BUREAU OF LAND & WATER RESOURCES


SEP 24 1984

RECEIVED

DRILLERS REMARKS:

If well telescopes please sketch and show depths.

GROUND LEVEL

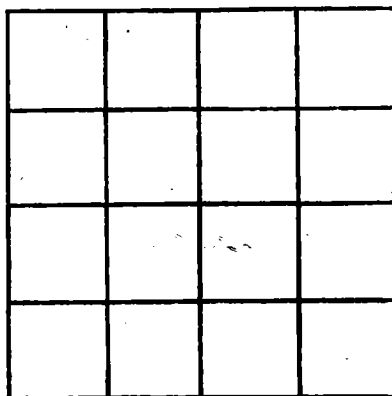

SECTION _____

Please indicate well location X.

ADDITIONAL INFORMATION

If more than one screen,
show locations of each on sketch.