

JACKSON
 Q433
 2-19-84

MISSISSIPPI DEPARTMENT OF NATURAL RESOURCES
 Bureau of Land and Water Resources
 Southport Mall
 P.O. Box 10631
 Jackson, Mississippi 39209
WATER WELL DRILLERS LOG

CODED

2-19-1984 HARNER DRILLING SER. JACKSON
 date well completed firm name county well located

LANDOWNER: CITY OF MOSS POINT, T.H.#2

(mailing address)

WELL LOCATION: NW 1/4 SE 1/4 SW 1/4
 sec. 18 T. 7 N. R. 5 E.
 (S) (W)

(distance) miles (direction) of (nearest town)

WELL PURPOSE: Dr. Hole
 (home, irrigation, municipal, industrial)

WELL COMPLETION DATA:

- (1) diameter (inches) _____
- (2) total depth (feet) _____
- (3) static water level (feet) _____ below above top of ground.
- (4) casing (material) (depth) _____
 (size) If telescope see back.
- (5) screen (length) (depth to top) _____
 (size) (material)
- (6) pump (HP) (yield gpm) _____
 (type power)
- (7) electric log (yes or no) _____
 (organization running log)
- (8) how well bottom plugged _____

2-19-84
 HARNER
 DRILLING
 SER.

description of formations encountered	from	to
TOP SOIL	0	3
CLAY	3	50
SAND	50	110
CLAY	110	164
SAND	164	164
CLAY + SAND STREAMS	164	190
CLAY, w/ thin rocks	190	244
SAND, MED.	244	272
CLAY	272	310
CLAY + SAND STREAMS	310	354

DEPT. OF NATURAL RESOURCES
 BUREAU OF LAND & WATER RESOURCES


APR 30 1984

RECEIVED

DRILLERS REMARKS:

If well telescopes please sketch and show depths.

GROUND LEVEL

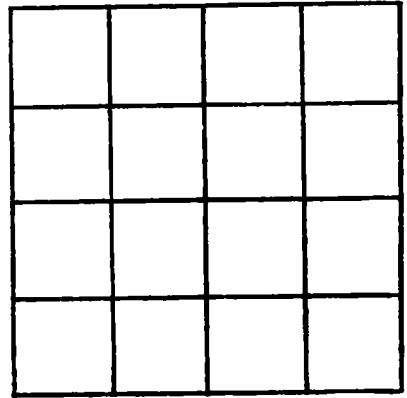

SECTION _____

Please indicate well location X.

ADDITIONAL INFORMATION

If more than one screen,
show locations of each on sketch.